

MISSISSIPPI DEPARTMENT OF ENVIRONMENTAL QUALITY
Office of Land and Water Resources

P. O. Box 10631
 Jackson, MS 39289-0631
WATER WELL DRILLERS LOG

COUNTY WELL LOCATED <i>Marion</i>	
WELL NUMBER <i>L-0026</i>	CODED
DATE WELL COMPLETED <i>7-31-2001</i>	

PERMIT NUMBER <i>0-586</i>
NAME OF DRILLING FIRM <i>James Wells</i>
<i>Water Well Ser.</i>

NAME & MAILING ADDRESS OF LANDOWNER <i>John Dale</i>		
<i>4650 Le River RD</i>		
<i>465 Columbia MS 39429</i>		
WELL LOCATION: SEC	TOWNSHIP	RANGE
<i>35</i>	<i>3</i>	<i>18</i>
DISTANCE	DIRECTION	NEAREST TOWN
<i>5</i> Miles	<i>South</i>	<i>Columbia</i>
OTHER LANDMARK		
WELL PURPOSE <input checked="" type="checkbox"/> Home Irrigation, Municipal, Industrial, Fish Pond, etc.		

PUMP DATA		
PUMP TYPE (Circle One): <input checked="" type="checkbox"/> Submersible, Turbine, Jet, Flowing Well, Other (Describe) _____		
POWER TYPE (Circle One): <input checked="" type="checkbox"/> Electric, Tractor, Diesel, Gasoline, Butane, Other (Describe) _____ H/P <i>1</i>		
Pump Capacity (GPM)	No. of Stages	Setting Depth _____ FT.
PUMP TEST		
Well yielded _____ <i>15</i> GPM with a drawdown of _____ ft. after _____ hours of pumping		

WELL DATA		
Well Depth <i>45</i>	Casing Diameter (In.) <i>4</i>	Casing Length (Ft.) <i>35</i>
Type of Casing <i>PVC</i>	Hole Depth <i>45</i>	Depth to Static Water Level <i>30</i>

LOG DATA	
TYPE OF LOG RUN (Circle One): <input checked="" type="checkbox"/> No Log Run, Electric, Gamma Ray, Density, Sonic, Neutron, Other (Describe) _____	
Name of Organization Running Log	

TYPE OF COMPLETION: (Circle One or More): <input checked="" type="checkbox"/> Gravel Packed, Underreamed, Telescoped, Natural Development, Open Hole, Other (Describe) _____			
WELL GROUTED TO A DEPTH OF <i>10</i> FEET Type Grout (circle one): <input checked="" type="checkbox"/> Cement, Bentonite, or Mix			

GEOLOGIC DATA (Office Use Only)			
Surface Elev.	Geologic Unit	Unit Thickness	Depth to Top
Subs. SWL	Date	Analysis	Aquifer Test

SCREEN DATA		
Diameter - Inches <i>4</i>	Length - Feet <i>10</i>	Slot Size - Inches <i>008</i>
Screen Type <i>PVC</i>	Depth to Bottom - Feet <i>35-45</i>	


Driller's Remarks	
Top of Lap Pipe or Reduction in Casing	
FEET	IF TELESCOPED OR MORE THAN ONE SCREEN: USE BACK PAGE

DESCRIPTION OF FORMATIONS ENCOUNTERED	FROM	TO	FORMATIONS (Continued)	FROM	TO
<i>Top Soil</i>	<i>0</i>	<i>2</i>			
<i>Sand</i>	<i>2</i>	<i>10</i>			
<i>Clay</i>	<i>10</i>	<i>15</i>			
<i>Sand</i>	<i>15</i>	<i>45</i>			

RECEIVED
FEB 05 2002
BY: OLWR

If well telescopes please
sketch and show depths.

GROUND LEVEL

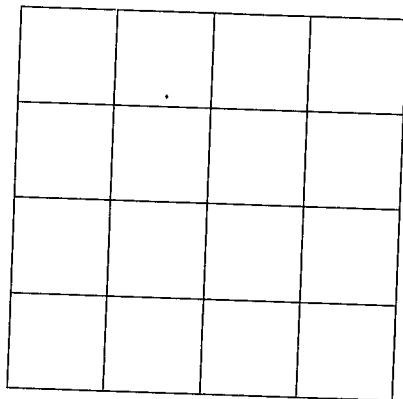

SECTION _____

Please indicate well location X.

ADDITIONAL INFORMATION

If more than one screen,
show location of each on sketch.