

Marion
M 37
3/75

MISSISSIPPI
BOARD OF WATER COMMISSIONERS
416 North State Street
Jackson, Mississippi 39201

CODED

WATER WELL DRILLERS LOG

March 1975 E.B. Sherrard Marion
date well completed firm name county well located

LANDOWNER:
Thomas Sanders
Columbia, Ms.
(mailing address)

description of formations encountered	from	to
B.F.D. SANDY clay	70'	70'
COARSE GR. SAND	70'	80'

WELL LOCATION:
sec 17 T 3 N R 17 E
S W
5 miles SE of Columbia
(distance) (direction) (nearest town)

WELL PURPOSE:
(home, irrigation, municipal, industrial)

- WELL COMPLETION DATA:
- (1) diameter (inches) 2"
 - (2) total depth (feet) 80'
 - (3) static water level (feet) 70' ^{below}/_{above} top of ground.
 - (4) casing galv. 75' (material) (depth)
2" (size) if telescope see back.
 - (5) screen 3' (length) (depth to top)
2" galv. (size) (material)
 - (6) pump rod pump #2 (HP) (yield gpm)
E (type power)
 - (7) electric log (yes or no) (no)
(organization running log)
 - (8) how well bottom plugged BWV


DRILLERS REMARKS:

RECEIVED
MAY 8 1975

MISS. BD. OF WATER COMMISSIONERS

If well telescopes please sketch and show depths.

GROUND LEVEL

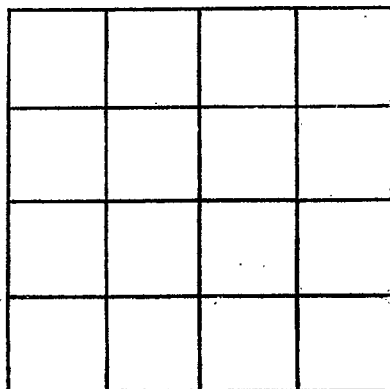

SECTION _____

Please indicate well location X.

ADDITIONAL INFORMATION

If more than one screen, show locations of each on sketch.