

Marion
M 38
3-28-70

MISSISSIPPI
BOARD OF WATER COMMISSIONERS
416 North State Street
Jackson, Mississippi 39201

CODED

WATER WELL DRILLERS LOG

3/28 1970 STR Marion
date well completed firm name county well located

LANDOWNER: Fredy Stone
RT 1 Box 429
Columbia, Miss.
(mailing address)

description of formations encountered	from	to
<u>Red Silty Clay</u>	<u>0</u>	<u>26</u>
<u>Fine Sand</u>	<u>26</u>	<u>37</u>
<u>Pink Clay</u>	<u>37</u>	<u>39</u>
<u>Fine Sand</u>	<u>39</u>	<u>58</u>
<u>Dark Clay</u>	<u>58</u>	<u>61</u>
<u>Fine Sand</u>	<u>61</u>	<u>101</u>
<u>P.W.B. Sand</u>	<u>101</u>	<u>118</u>
<u>Red Clay</u>	<u>118</u>	<u>122</u>

WELL LOCATION:
sec. 6 T. 3 N. R. 17 E.
S W
6 miles E of Columbia
(distance) (direction) (nearest town)

WELL PURPOSE: Home
(home, irrigation, municipal, industrial)

- WELL COMPLETION DATA:
- (1) diameter (inches) 2"
 - (2) total depth (feet) 118
 - (3) static water level (feet) 50 below above top of ground.
 - (4) casing plastic 113
(material) (depth)
 - 2"
(size) If telescope see back.
 - (5) screen 5 ft 113
(length) (depth to top)
 - 2"
(size) (material)
 - (6) pump 1 600 ft.
(HP) (yield gpm)
 - 1/2
(type power)
 - (7) electric log _____
(yes or no)
 - _____ (organization running log)
 - (8) how well bottom plugged None


MAY 4 1970

MISS. BD. OF
WATER COMM.

DRILLERS REMARKS:

If well telescopes please sketch and show depths.

GROUND LEVEL

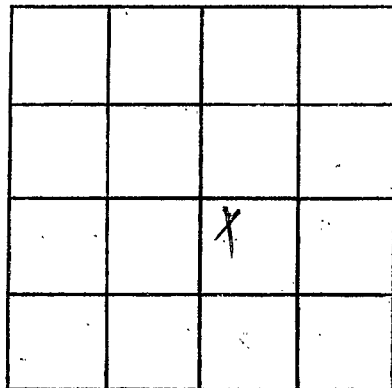

SECTION 6

Please indicate well location X.

ADDITIONAL INFORMATION

If more than one screen,
show locations of each on sketch.