

MISSISSIPPI
BOARD OF WATER COMMISSIONERS
416 North State Street
Jackson, Mississippi 39201

CODED

WATER WELL DRILLERS LOG

MARION
M39
5-70

May 1970 E. B. SHEPPARD MARION
date well completed firm name county well located

LANDOWNER: Mrs. S. M. Bullock
% OTTIS P. BULLOCK
Rt. 2 - Columbia, Miss.
(mailing address)

description of formations encountered	from	to
RED SANDY CLAY	0	70'
BIG GRAVEL	70	86'
COARSE SAND & GRAVEL	80	108'

WELL LOCATION:
sec 12 T 3 N R 17 E
S W
11 miles ESE of Columbia
(distance) (direction) (nearest town)

WELL PURPOSE:
(home irrigation, municipal, industrial)

CODED

- WELL COMPLETION DATA:
- (1) diameter (inches) 2"
 - (2) total depth (feet) 108'
 - (3) static water level (feet) 68 below above top of ground.
 - (4) casing PLASTIC, 103'
(material) (depth)
2" if telescope see back.
(size)
 - (5) screen 3'
(length) (depth to top)
2" S.S.
(size) (material)
 - (6) pump 3/4 7
(HP) (yield gpm)
E
(type power)
 - (7) electric log (yes or no) (no)

(organization running log)
 - (8) how well bottom plugged BWV


AUG 13 1970

DRILLERS REMARKS:

MISS. BD. OF
WATER COMM.

If well telescopes please sketch and show depths.

GROUND LEVEL

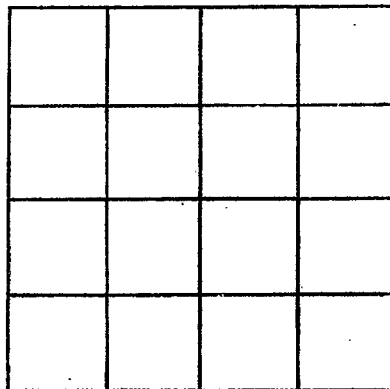

SECTION _____

Please indicate well location X.

ADDITIONAL INFORMATION

If more than one screen,
show locations of each on sketch.