

MISSISSIPPI
 BOARD OF WATER COMMISSIONERS
 416 North State Street
 Jackson, Mississippi 39201

CODED

WATER WELL DRILLERS LOG

MARION
 M 42
 10-70

date well completed Oct 1970 firm name E.B. SHERRARD county well located MARION

LANDOWNER:
CHARLES RANKIN
COLUMBIA, Miss.
 (mailing address)

description of formations encountered	from	to
<u>RED SANDY CLAY</u>	<u>0</u>	<u>60'</u>
<u>SAND</u>	<u>60</u>	<u>80'</u>
<u>LOOSE LARGE GRAVEL</u>	<u>80'</u>	<u>105'</u>
<u>REA GRAVEL SMALL</u>	<u>105'</u>	<u>118'</u>

WELL LOCATION:
 sec. 13 T. 30 S. R. 17 E.
11 miles ESE of COLUMBIA
 (distance) (direction) (nearest town)

WELL PURPOSE:
 home, irrigation, municipal, industrial

WELL COMPLETION DATA:

- (1) diameter (inches) 2"
- (2) total depth (feet) 118
- (3) static water level (feet) 78 below top of ground. above
- (4) casing PL. (material), 113 (depth),
2" (size) if telescope see back.
- (5) screen 5' (length), (depth to top)
2" (size), S.S. (material)
- (6) pump 3/4 (HP), 7 (yield gpm)
F (type power)
- (7) electric log (yes or no)
1 (organization running log)
- (8) how well bottom plugged BWV

CODED


FEB 1 1971

DRILLERS REMARKS:

MISS. BD. OF
 WATER CONTROL

If well telescopes please sketch and show depths.

GROUND LEVEL

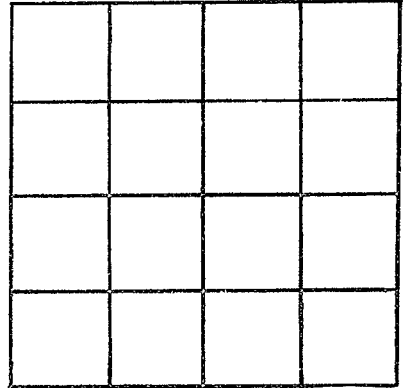

SECTION _____

Please indicate well location X.

ADDITIONAL INFORMATION

If more than one screen, show locations of each on sketch.