

MARION
M 43
1-71

MISSISSIPPI
BOARD OF WATER COMMISSIONERS
416 North State Street
Jackson, Mississippi 39201

CODED

WATER WELL DRILLERS LOG

JAN. 1971 E. B. SHERRARD MARION
date well completed firm name county well located

LANDOWNER:

HOYT REYER
COLUMBIA
(mailing address)

description of formations
encountered

from to

RED SANDY CLAY 0 44
GRAVEL SAND 44 65
BLUE CLAY 65 100
FINE SAND 100 240
COARSE GRAVEL SAND & PEA GR. 240 268

WELL LOCATION:

sec. 21 T. 30 (N) R. 17 (E)
S (W)
8 miles SE of COLUMBIA
(distance) (direction) (nearest town)

WELL PURPOSE:

(home) irrigation, municipal, industrial

WELL COMPLETION DATA:

- (1) diameter (inches) 4"
(2) total depth (feet) 268
(3) static water level (feet) 200 (below above top of ground.)
(4) casing PL 258,
(material) (depth)
4" if telescope see back.
(size)
(5) screen 10' (length) (depth to top)
4" (size) PL (material)
(6) pump 1-SUB 14
(HP) (yield gpm)
F
(type power)
(7) electric log (yes or no) (no)
(organization running log)
(8) how well bottom plugged BWV

CODED


MAY 27 1971

MISS. RD. OR
WATER COMM.

DRILLERS REMARKS:

If well telescopes please sketch and show depths.

GROUND LEVEL

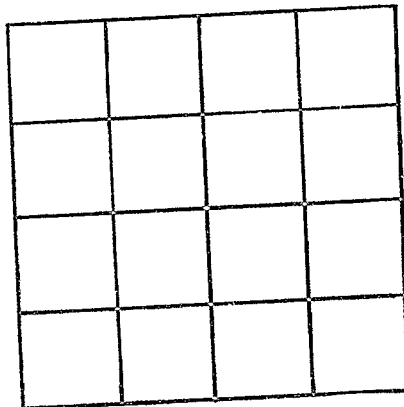

SECTION _____

Please indicate well location X.

ADDITIONAL INFORMATION

If more than one screen,
show locations of each on sketch.