

MISSISSIPPI
BOARD OF WATER COMMISSIONERS
416 North State Street
Jackson, Mississippi 39201

CODED

WATER WELL DRILLERS LOG

Marion
M-44
6-71

JUNE 1971 E.B. SHERRARD Marion
date well completed firm name county well located

LANDOWNER:	description of formations encountered	from	to
JOHNNIE O'GWYNN COLUMBIA (mailing address)	LOOSE SAND FINE GRAVEL COARSE SAND	0	75' 102'
WELL LOCATION:			
sec. 13 T 3 N R 17 E S W 9 miles ESE of COLUMBIA (distance) (direction) (nearest town)			
WELL PURPOSE: (home) Irrigation, municipal, industrial)			
WELL COMPLETION DATA:			
(1) diameter (inches) 2"			
(2) total depth (feet) 102			
(3) static water level (feet) 58 below above top of ground.			
(4) casing PL, 97 (material) (depth)			
2" If telescope see back. (size)			
(5) screen 5' (length) (depth to top)			
2" PL, (size) (material)			
(6) pump 3/4 8 (HP) (yield gpm)			
E (type power)			
(7) electric log (yes or no)			
(organization running log)			
(8) how well bottom plugged BWV			
DRILLERS REMARKS:			


CODED

SEP 15 1971

MISS. BD. OF
WATER COMMISSIONERS

If well telescopes please sketch and show depths.

GROUND LEVEL

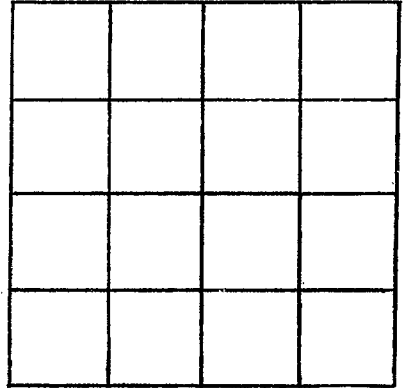

SECTION _____

Please indicate well location X.

ADDITIONAL INFORMATION

If more than one screen,
show locations of each on sketch.