

MARION  
 M-45  
 8-71

MISSISSIPPI  
 BOARD OF WATER COMMISSIONERS  
 416 North State Street  
 Jackson, Mississippi 39201

**CODED**

WATER WELL DRILLERS LOG

August 1971 E. B. SHERRARD MARION  
 date well completed firm name county well located

**LANDOWNER:**  
 LARRY Bullock  
 Columbia  
 (mailing address)

description of formations encountered	from	to
GRAY CLAY	0	120'
SMALL SAND	120'	170'
BLUE CLAY	170'	510'
COARSE SAND	510'	550'

**WELL LOCATION:**  
 sec. 2 T. 3 N. R. 17 E.  
 S W  
 8 miles E of Columbia  
 (distance) (direction) (nearest town)

**WELL PURPOSE:**  
 home,  irrigation,  municipal,  industrial

- WELL COMPLETION DATA:**
- (1) diameter (inches) 3"
  - (2) total depth (feet) 550
  - (3) static water level (feet) 95 below above top of ground.
  - (4) casing PL 544,  
 (material) (depth)  
3" if telescope see back.  
 (size)
  - (5) screen 6,  
 (length) (depth to top)  
3" SS,  
 (size) (material)
  - (6) pump 1/2 E  
 (HP) (yield gpm)  
 (type power)
  - (7) electric log (yes or no)

**CODED**

(organization running log)  
 (8) how well bottom plugged B.W.V.


SFP 15 1971

DRILLERS REMARKS:

MISS. BD. OF  
 WATER COMM.

If well telescopes please sketch and show depths.

GROUND LEVEL

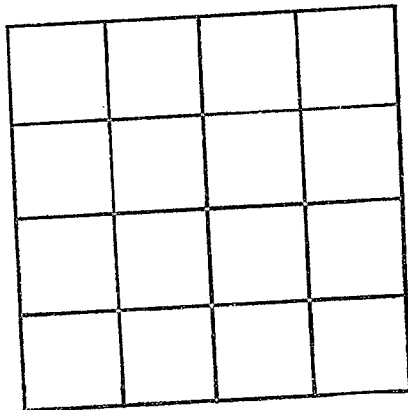

SECTION \_\_\_\_\_

Please indicate well location X.

ADDITIONAL INFORMATION

If more than one screen, show locations of each on sketch.