

MARION

M46

2-5-71

MISSISSIPPI
 BOARD OF WATER COMMISSIONERS
 416 North State Street
 Jackson, Mississippi 39201

CODED

WATER WELL DRILLERS LOG

2-5-71
date well completed

Dean Grimes Well Service
firm name

Marion
county well located

LANDOWNER:

Vester Anderson

Route Columbia, Miss.
(mailing address)

WELL LOCATION:

sec. 4 T. 3 N. R. 17 E.
S. 17 W.

12 miles East of Columbia
(distance) (direction) (nearest town)

WELL PURPOSE: Home Use
(home, irrigation, municipal, industrial)

WELL COMPLETION DATA:

- (1) diameter (inches) 4"
- (2) total depth (feet) 170'
- (3) static water level (feet) 120' below top of ground.
- (4) casing Plastic, 170'
(material) (depth)
If telescope see back.
(size)
- (5) screen 10' 160'
(length) (depth to top)
4" Plastic
(size) (material)
- (6) pump 1/2 Sub.
(HP) (yield gpm)
(type power)
- (7) electric log (yes or no)
(organization running log)
- (8) how well bottom plugged

description of formations encountered

from to

top soil	0	1
sand	1	17
clay	17	80
Chalk	80	120
fine sand	120	145
water sand	145	170

CODED


OCT 21 1971

DRILLERS REMARKS:

MISS. RD. OR
WATER COMMISSION

If well telescopes please sketch and show depths.

GROUND LEVEL

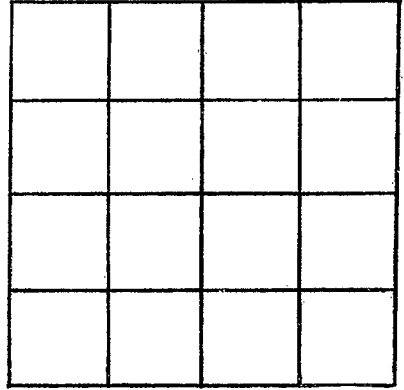

SECTION _____

Please indicate well location X.

ADDITIONAL INFORMATION

If more than one screen, show locations of each on sketch.