

MISSISSIPPI
BOARD OF WATER COMMISSIONERS
416 North State Street
Jackson, Mississippi 39201

CODED

WATER WELL DRILLERS LOG

MARION
M 47
5-18-72

5-18 1972 Drinking water well Drilling Marion
date well completed firm name county well located

LANDOWNER:
Mr. Ramon Cook
141 Columbia Miss.
(mailing address)

WELL LOCATION:
sec. 21 T. 3 N. R. 7 E.
1.5 miles S.E. of Columbia
(distance) (direction) (nearest town)

description of formations encountered	from	to
<u>Top soil</u>	<u>0</u>	<u>1/2'</u>
<u>gravel</u>	<u>4</u>	<u>11'</u>
<u>clay</u>	<u>41</u>	<u>67'</u>
<u>gravel</u>	<u>67</u>	<u>79'</u>
<u>sand</u>	<u>79</u>	<u>95'</u>
<u>water sand</u>	<u>95</u>	<u>103'</u>

WELL PURPOSE: home
(home, irrigation, municipal, industrial)

WELL COMPLETION DATA:

(1) diameter (inches) 4"

(2) total depth (feet) 103'

(3) static water level (feet) _____ below
top of ground. above

(4) casing Plastic, 93'
(material) (depth)
4" if telescope see back.
(size)

(5) screen 10', 93'
(length) (depth to top)
1", Plastic
(size) (material)

(6) pump 1, 45
(HP) (yield gpm)
electric
(type power)

(7) electric log _____
(yes or no)

(organization running log)

(8) how well bottom plugged _____

CODED


JUL 19 1972

DRILLERS REMARKS:

MISS. BD. OF
WATER COM.

If well telescopes please sketch and show depths.

GROUND LEVEL

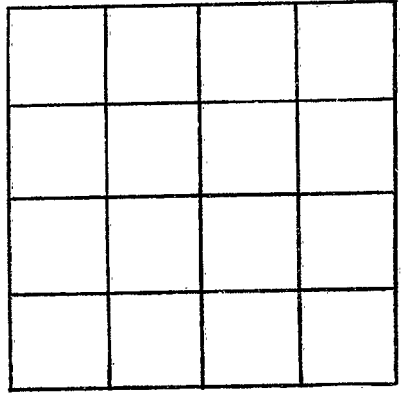

SECTION _____

Please indicate well location X.

ADDITIONAL INFORMATION

If more than one screen, show locations of each on sketch.