

MARION

M 48

12-71

MISSISSIPPI  
 BOARD OF WATER COMMISSIONERS  
 416 North State Street  
 Jackson, Mississippi 39201

**CODED**

WATER WELL DRILLERS LOG

Dec 1971  
date well completed

E. B. Sherrard Marion  
firm name county well located

LANDOWNER:

Lawrence Brown

Columbia, Miss.  
(mailing address)

description of formations encountered

	from	to
BLuish CLAY	0	15
SAND & GR.	15	25
GRAY CLAY	25	110
COARSE WHITE SAND	110	165

WELL LOCATION:

sec. 2 T 3 N R 17 E  
 S  
8 miles E of Columbia  
 (distance) (direction) (nearest town)

WELL PURPOSE:

(home) irrigation, municipal, industrial

WELL COMPLETION DATA:

- (1) diameter (inches) 3"
- (2) total depth (feet) 165
- (3) static water level (feet) 90 below top of ground.
- (4) casing pl. 139'  
(material) (depth)  
3" If telescope see back.  
(size)
- (5) screen 6' pl.  
(length) (depth to top)  
3" pl.  
(size) (material)
- (6) pump 2 9  
(HP) (yield gpm)
- (7) ele. power 8

**CODED**

(yes or no)  
 (organization) log

(8) how well bottom plugg. B.W.W.


JUL 28 1972

MISC. DATE

DRILLERS REMARKS:

If well telescopes please sketch and show depths.

GROUND LEVEL

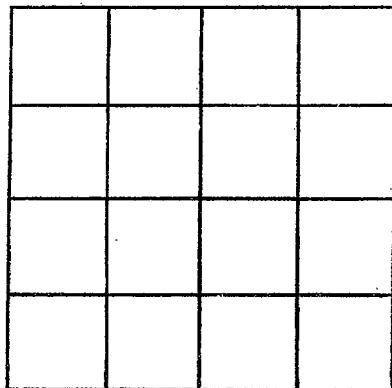

SECTION \_\_\_\_\_

Please indicate well location X.

ADDITIONAL INFORMATION

If more than one screen, show locations of each on sketch.