

MARION
M 49
2-73

MISSISSIPPI
BOARD OF WATER COMMISSIONERS
416 North State Street
Jackson, Mississippi 39201

CODED

WATER WELL DRILLERS LOG

Feb. 1973 E.B. Sheppard Marion
date well completed firm name county well located

LANDOWNER:
Billie Sue Bullock
Columbia
(mailing address)

description of formations encountered	from	to
LOOSE RED SANDY CLAY SAND	0	60
	60	92

WELL LOCATION:
sec. 12 T. 3 N. R. 17 E. W. Columbia
9 miles E of Columbia
(distance) (direction) (nearest town)

WELL PURPOSE:
(home, irrigation, municipal, industrial)


- WELL COMPLETION DATA:
- (1) diameter (inches) 2"
 - (2) total depth (feet) 92'
 - (3) static water level (feet) 55' below top of ground.
 - (4) casing (material) pl. (depth) 87'
3" (size) if telescope see back.
 - (5) screen 5' (length) (depth to top)
2" (size) pl. (material)
 - (6) pump 1 (HP) 7 (yield gpm)
E (type power)
 - (7) electric log (yes or no)
 - (organization running log)
 - (8) how well bottom plugged BWV

CODED

DRILLERS REMARKS:

If well telescopes please sketch and show depths.

GROUND LEVEL

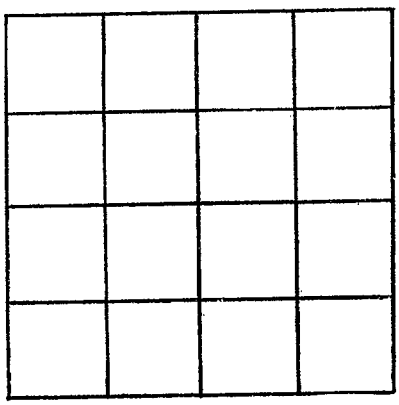

SECTION _____

Please indicate well location X.

ADDITIONAL INFORMATION

A series of horizontal lines for recording additional information.

If more than one screen, show locations of each on sketch.