

MARION
MSI
4-73

MISSISSIPPI
BOARD OF WATER COMMISSIONERS
416 North State Street
Jackson, Mississippi 39201

CODED

WATER WELL DRILLERS LOG

April 1973 E.B. Sherrard Marion
date well completed firm name county well located

LANDOWNER:

Bobby Rousee
Columbia
(mailing address)

description of formations
encountered

from to

RED SANDY
CLAY GR
GRAVEL
PEA GR. + SAND
0 60'
60 90'
90 112'

WELL LOCATION:

sec 15 T. 3 N R 17 E
1 1/2 miles SE Columbia
(distance) (direction) of (nearest town)

WELL PURPOSE:

(home, irrigation, municipal, industrial)

WELL COMPLETION DATA:


- (1) diameter (inches) 2"
(2) total depth (feet) 112'
(3) static water level (feet) 68 below above
top of ground.
(4) casing: pl. 107'
(material) (depth)
2" if telescope see back.
(size)
(5) screen 5'
(length) (depth to top)
2" pl.
(size) (material)
(6) pump 1 (HP) 7 (yield gpm)
E
(type power)
(7) electric log (yes or no)
(organization running log)
(8) how well bottom plugged BWV

CODED

DRILLERS REMARKS:

If well telescopes please sketch and show depths.

GROUND LEVEL

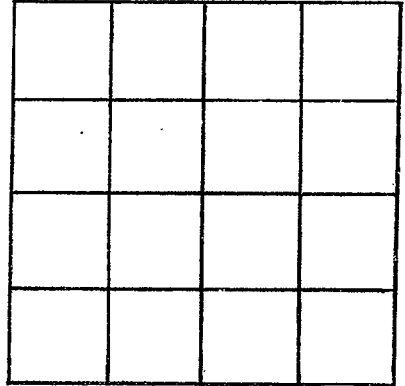

SECTION _____

Please indicate well location X.

ADDITIONAL INFORMATION

If more than one screen,
show locations of each on sketch.