

MARION  
M 52  
9-1-73

MISSISSIPPI  
BOARD OF WATER COMMISSIONERS  
416 North State Street  
Jackson, Mississippi 39201

CODED

WATERWELL DRILLERS LOG

9/1 1973 Lawyer-Grow Marion  
date well completed firm name county well located

LANDOWNER: J. L. ENTREKIN

description of formations encountered

from to

Rt #4

Top Soil

0 1

Lumberton

Clay

1 96

(mailing address)

Sand

96 123

WELL LOCATION:

sec. 26 T. 3 N. R. 17 E.  
8 miles SE of Columbus  
(distance) (direction) (nearest town)

WELL PURPOSE:

(home, irrigation, municipal, industrial)

WELL COMPLETION DATA:

CODED

- (1) diameter (inches) 2"
- (2) total depth (feet) 123'
- (3) static water level (feet) 80 <sup>below</sup> ~~above~~ top of ground.
- (4) casing 2" 113'  
(material) (depth)  
2" if telescope see back.  
(size)
- (5) screen 10' 113'  
(length) (depth to top)  
3" Plastic  
(size) (material)
- (6) pump 1 1/2 8  
(HP) (yield gpm)  
Elec  
(type power)
- (7) electric log NO  
(yes or no)

(organization running log)


(8) how well bottom plugged BN Valve

DRILLERS REMARKS:

OCT 9 1973

If well telescopes please sketch and show depths.

GROUND LEVEL

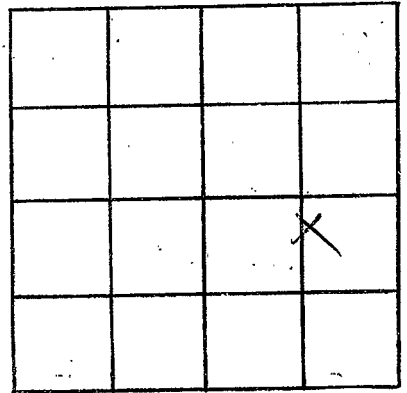

SECTION \_\_\_\_\_

Please indicate well location X.

ADDITIONAL INFORMATION

If more than one screen,  
show locations of each on sketch.