

MARION
M53
9-1-73

MISSISSIPPI
BOARD OF WATER COMMISSIONERS
416 North State Street
Jackson, Mississippi 39201

CODED

WATER WELL DRILLERS LOG

9/1 1973 Guines-Quinn MARION
date well completed firm name county well located

LANDOWNER: S. L. Cannon

description of formations encountered

from to

Top Soil	0	1
Clay	1	23
Clay + gravel	23	255
Sand	255	295

(mailing address)

WELL LOCATION:

sec 36 T 3 N R. 17 W
10 miles SE of Columbus
(distance) (direction) (nearest town)

WELL PURPOSE: Home
(home, irrigation, municipal, industrial)

WELL COMPLETION DATA:

- (1) diameter (inches) 4
- (2) total depth (feet) 295
- (3) static water level (feet) 170 below top of ground.
- (4) casing Plastic 285 ft
(material) (depth)
4" if telescope see back.
(size)
- (5) screen 10 ft 285'
(length) (depth to top)
4" Plastic
(size) (material)
- (6) pump 3/4 HP stage 9
(HP) (yield gpm)
elec
(type power)
- (7) electric log no
(yes or no)

COILED

(organization running log)


(8) how well bottom plugged
Don't know

DRILLERS REMARKS:

FORM 6 1973

If well telescopes please sketch and show depths.

GROUND LEVEL

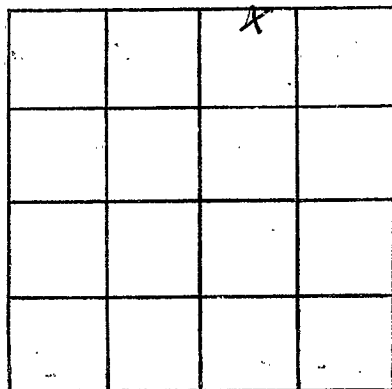

SECTION _____

Please indicate well location X.

ADDITIONAL INFORMATION

If more than one screen,
show locations of each on sketch.