

Marion
M54
7175

MISSISSIPPI
BOARD OF WATER COMMISSIONERS
416 North State Street
Jackson, Mississippi 39201

CODED

WATER WELL DRILLERS LOG

July
date well completed

1975 E. B. SHERARD
firm name

MARION
county well located

LANDOWNER:
Mrs. HELEN LADNER
Rt. 2 - Columbia, Miss.
(mailing address)

description of formations encountered	from	to
GRAY CLAY	0	80
13' LT CLAY	80	200
COARSE SAND	200	236

WELL LOCATION:
sec. 19 T. 30 N. R. 17 E.
6 miles SE of COLUMBIA
(distance) (direction) (nearest town)

WELL PURPOSE:
(home) Irrigation, municipal, industrial

- WELL COMPLETION DATA:
- (1) diameter (inches) 2"
 - (2) total depth (feet) 235'
 - (3) static water level (feet) 140' ^{below} above top of ground.
 - (4) casing apl. 230' (material) (depth)
2" (size) if telescope see back.
 - (5) screen 5' (length) (depth to top)
2" (size) apl. (material)
 - (6) pump 2 (HP) 7 (yield gpm)
E (type power)
 - (7) electric log yes (no)
 - (8) how well bottom plugged BWV


DRILLERS REMARKS:

RECEIVED
MAY - 8 1975

MISS. BD. OF WATER COMM

If well telescopes please sketch and show depths.

GROUND LEVEL

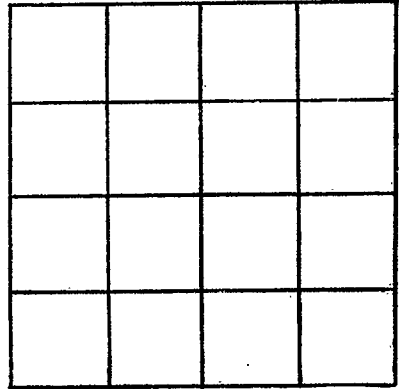

SECTION _____

Please indicate well location X.

ADDITIONAL INFORMATION

If more than one screen, show locations of each on sketch.