

MISSISSIPPI DEPARTMENT OF NATURAL RESOURCES

Bureau of Land and Water Resources

Southport Mall

P.O. Box 10631

CODED

Jackson, Mississippi 39209

WATER WELL DRILLERS LOG

TOM GRIFFITH

PLUMBING & WELL SERVICE, INC.

Marion

320 MAYSON AVE,

COLUMBIA, MS 39429

county well located

M57  
MARION CO  
5-5-84

5-5 1984  
date well completed

LANDOWNER: George Bourque

Description of formations encountered

from

to

125 West 117th  
Cut-off, La. 70345  
(mailing address)

Red Sand	1'	20'
Sand & Red Gravel	20'	115'
Clay	115'	120'
Sand	120'	150'
Clay	150'	220'
Red Gravel	220'	280'

WELL LOCATION:

sec. 22 T 30 N R 17 E  
8 miles E of Columbia  
(distance) (direction) (nearest town)

WELL PURPOSE: Home  
(home, irrigation, municipal, industrial)

WELL COMPLETION DATA:

- (1) diameter (inches) 4"
- (2) total depth (feet) 280'
- (3) static water level (feet) 215' below top of ground.
- (4) casing PVC 280' (material) (depth)  
NA if telescope see back. (size)
- (5) screen 30' 250' (length) (depth to top)  
4" PVC (size) (material)
- (6) pump 3 55 (HP) (yield gpm)  
elec. (type power)
- (7) electric log NA (yes or no)  
NA (organization running log)
- (8) how well bottom plugged BUW

DEPT. OF NATURAL RESOURCES  
BUREAU OF LAND & WATER RESOURCES


JUL 16 1984

RECEIVED

DRILLERS REMARKS:

If well telescopes please sketch and show depths.

GROUND LEVEL

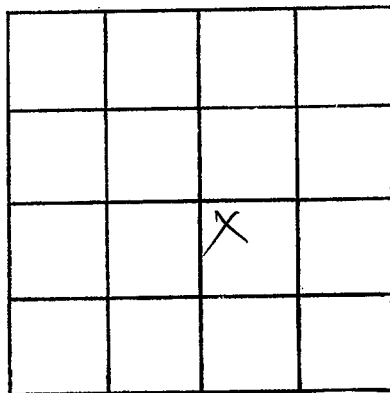

SECTION 22

Please indicate well location X.

ADDITIONAL INFORMATION

If more than one screen,  
show locations of each on sketch.