

MISSISSIPPI DEPARTMENT OF NATURAL RESOURCES

Bureau of Land and Water Resources

Southport Mall

P.O. Box 10631

Jackson, Mississippi 39209

CODED

WATER WELL DRILLERS LOG

TOM GRIFFITH

84 PLUMBING & WELL SERVICE, INC.

Marion

320 MAYSON AVE.

COLUMBIA, MS 39429

county well located

M58  
MARION  
6-4-84

6-4-19

LANDOWNER: Marvin L. Poik  
1432 Ridge wood  
Columbia MS 39429  
(mailing address)

WELL LOCATION:  
sec. 2 T 30 N R 17 E  
W miles 5 of Columbia  
(distance) (direction) (nearest town)

WELL PURPOSE: Home pump  
(home, irrigation, municipal, industrial)

WELL COMPLETION DATA:

(1) diameter (inches) 4"

(2) total depth (feet) 510'

(3) static water level (feet) Flow below above top of ground.

(4) casing PVC 4100'  
(material) (depth)  
4" if telescope see back.  
(size)

(5) screen 50' 460'  
(length) (depth to top)  
4" PVC .0105  
(size) (material)

(6) pump none 60  
(HP) (yield gpm)  
Accep  
(type power)

(7) electric log NA  
(yes or no)  
(organization running log)

(8) how well bottom plugged BWV

description of formations encountered	from	to
Sand	1'	30'
Clay	30'	70'
Pea Gravel	70'	80'
Clay	80'	102'
Sand & Pea Gravel	102'	170'
Clay	170'	210'
Sand	210'	320'
Clay	320'	330'
Sand	330'	510'

DRILLERS REMARKS: M58 Feb report available.  
No. 1 must fall out of jar of water after 24 hrs.

DEPT. OF NATURAL RESOURCES  
BUREAU OF LAND & WATER RESOURCES


JUL 16 1984

RECEIVED

If well telescopes please sketch and show depths.

Sheet 1

GROUND LEVEL

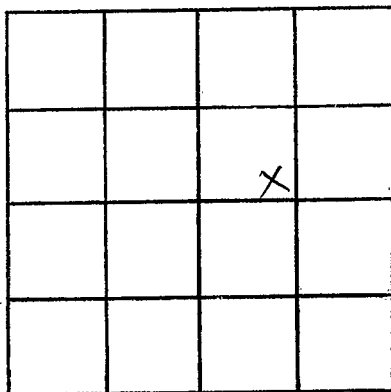

SECTION 2

Please indicate well location X.

ADDITIONAL INFORMATION

If more than one screen,  
show locations of each on sketch.