

MISSISSIPPI DEPARTMENT OF NATURAL RESOURCES

Bureau of Land and Water Resources

Southport Mall

P.O. Box 10631

Jackson, Mississippi 39209

WATER WELL DRILLERS LOG

CODED

M 6059
MARION
11-5-84

11-5-84 date well completed Cochran Water Well Service firm name Marion county well located

LANDOWNER:
C. L. Housley
241 Lumberton
(mailing address)

WELL LOCATION:
sec. 36 T. 3 N. R. 17 E.
8 miles NW of Purvis
(distance) (direction) (nearest town)

WELL PURPOSE:
(home, irrigation, municipal, industrial)

WELL COMPLETION DATA:

(1) diameter (inches) 2"

(2) total depth (feet) 242'

(3) static water level (feet) 88 below top of ground.

(4) casing PVC, 232' (material) (depth)
2" (size) if telescope see back.

(5) screen 10' 232' (length) (depth to top)
2" (size) PVC (material)

(6) pump 5 (HP) (yield gpm)
Elec (type power)

(7) electric log (yes or no)

(organization running log)

(8) how well bottom plugged calce

description of formations encountered	from to	
Top soil	0	1
Red clay	1	6
gray clay	6	81
Blue clay	81	178
sand	178	181
blue clay	181	214
sand	214	242


CODED

11-8-84
M

DRILLERS REMARKS:

If well telescopes please sketch and show depths.

GROUND LEVEL

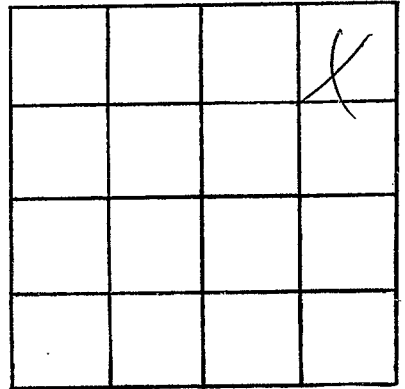

SECTION 11

Please indicate well location X.

ADDITIONAL INFORMATION

If more than one screen, show locations of each on sketch.