

MARION
M 60

MISSISSIPPI DEPARTMENT OF NATURAL RESOURCES

Bureau of Land and Water Resources

Southport Mall

P.O. Box 10631

Jackson, Mississippi 39209

CODED

WATER WELL DRILLERS LOG

Griner Drilling
Service, Inc.

Marion

5-31-90
date well completed

firm name

county well located

LANDOWNER:	description of formations encountered	from	to
Oryx Energy Co. P.O. Box 219003 Dallas, Texas 75221 (mailing address)			
WELL LOCATION: 745' S + 2062' W sec. 29 T 30 N R 17 E of Lake Bill Waller (distance) (direction) (nearest town)	clay	400	440
WELL PURPOSE: oilfield rig (home, irrigation, municipal, industrial) supply	sand	440	460
WELL COMPLETION DATA:			
(1) diameter (inches) 4"			
(2) total depth (feet) 460'			
(3) static water level (feet) 150' below top of ground.			
(4) casing PVC 440' (material) (depth) 4" (size) if telescope see back.			
(5) screen 20' From 440' (length) (depth to top) 4" PVC slotted (size) (material)			
(6) pump 7 1/2 HP 80 (yield gpm) 480 Volt 3 phase (type power)			
(7) electric log (yes or no) <input checked="" type="radio"/>			
(organization running log)			
(8) how well bottom plugged 4" plug & backwash valve			

RECEIVED


JUN 18 1990

Department of Natural Resources
Bureau of Land & Water Resources

DRILLERS REMARKS:

If well telescopes please sketch and show depths.

GROUND LEVEL

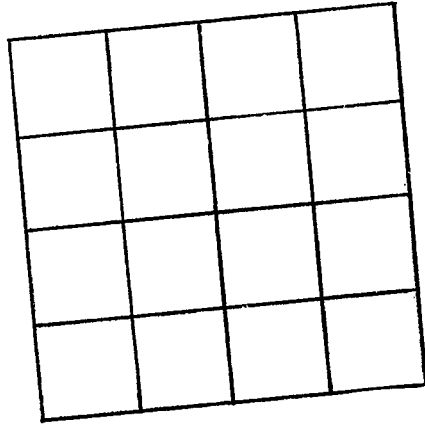

SECTION _____

Please indicate well location X.

ADDITIONAL INFORMATION

Lined area for additional information, consisting of approximately 20 horizontal lines.

If more than one screen, show locations of each on sketch.