

State Well Report

Part 1

Mississippi Department of Environmental Quality
 Office of Land and Water Resources
 P.O. Box 10631
 Jackson, MS 39289-0631
 (601)961-5210
 (601)354-6938 (fax)

For Office Use Only:

Aquifer: _____
 Well #: M-69
 L. S. Elevation: _____
 E-log #: _____

County: Marion 091
 Permit #: _____
 Driller: JAMES WELLS
 Date drilling completed: 8-8-04

James Wells Water Well Service

State Law requires that this report be prepared by the driller in detail and filed with the Department within 30 days of completion of drilling of the well.

Well Owner Information	Well Location
Owner Name: <u>Wallace Carson</u>	Latitude: <u>31°14'57"</u> Longitude: <u>89°41'18"</u>
Mailing Address: <u>50 Carson Ln.</u>	Method of Lat/Long (circle one): <u>Conventional Survey</u>
<u>Columbia, MS 39429</u>	USGS quad, Hand-held GPS, Survey-grade GPS
City State Zip Code	<u>4 1/4 NE 1/4 Sec 3 Twn 3N Rng 17W</u>
Telephone No. <u>(601) 736-3715</u>	Distance <u>6</u> Miles <u>East</u> of <u>Columbia</u>

Well Data

Purpose of Well (circle one) Home ~~Public Supply~~ Public Supply Irrigation Fish Culture Other: _____

Date well drilling started: 8-8-04 Date well drilling completed: 8-8-04

If flowing, method of flow regulation: Valve _____ Other (describe) _____

Static Water Level: 70 feet above ok below (circle one) ~~land surface~~ Date measured: 8-8-04

Method of Measurement (circle one) steel tape Electric tape air line other: _____

Hole depth: 140 Well depth: 140 Well grouted to a depth of 15 feet

Type of grout (circle one): Cement Bentonite Mix

Casing length: 120 feet Casing diameter: 4 inches Type of casing: PVC

Screen length: 20 feet Screen diameter: 4 inches Type of screen: PVC

Screen slot size: .008 inches Setting depth: From 120 feet to 140 feet

Type of completion (circle all applicable): Gravel packed Underreamed Telescoped Open hole Natural Development

Other (describe): _____

Top of lap pipe or reduction in casing: _____ feet. If telescoped or more than one screen, describe on back of page

Logs run (circle all applicable): No log run Electric Gamma Ray Density Sonic Neutron Other: _____

Name of organization running log(s): _____

RECEIVED
 SEP 08 2004
 BY: OLW

I certify that the well was drilled, constructed, and completed in accordance with all applicable requirements of the Mississippi Department of Environmental Quality and/or the Mississippi Department of Health regulations and state laws.

James Wells Water Well Ser. 0-586
 Print Name of Water Well Contractor and License No.

James Wells
 Signature of Water Well Contractor

If well telescopes please sketch below and show depths.


M-69

Ground Level

Description of Formations Encountered	From	To
Top Soil	0	2
Clay	2	40
Sand	40	50
Clay	50	70
Sand	70	150

If more than one screen, show location of each on sketch

Sketch the property layout and include the following: 1) the well location; 2) any permanent structures on the property that may aid in locating the well; 3) any roads, power lines, or other items that may aid in locating the property and the well; 4) indicate direction.

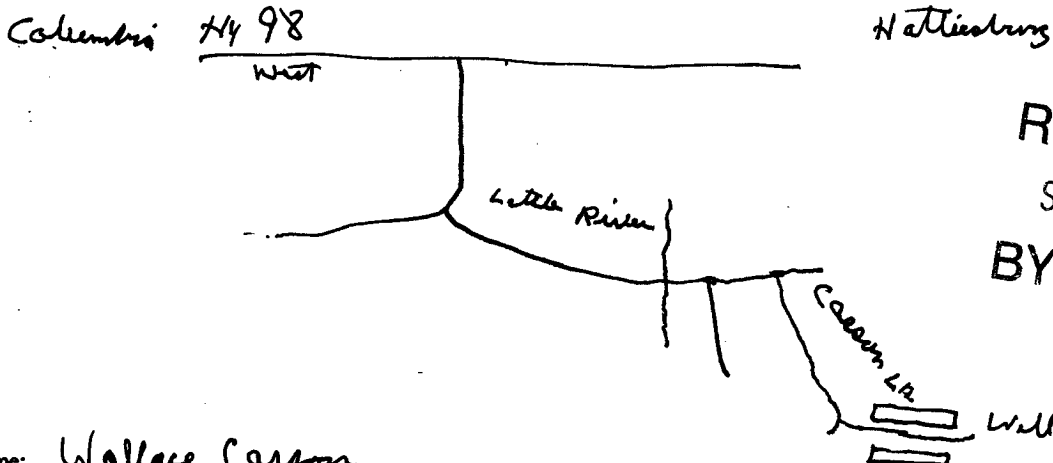

RECEIVED
SEP 08 2004
BY: OLWR

Landowner Name: Wallace Carson

James Wells
Signature of Water Well Contractor

STATE WELL REPORT

Part 2

Pump Installer's Completion Report
 Mississippi Department of Environmental Quality
 Office of Land and Water Resources
 P.O. Box 10631
 Jackson, MS 39289-0631
 (601)961-5210
 (601)354-6938 (fax)

For Office Use Only:

Aquifer: _____
 Well #: M-69
 Elevation: _____

County: Marion
 Permit #: _____
 Driller: JAMES WELLS
 Date completed: 8-8-04

This report should be prepared by the pump installer in detail and filed with the Department within 30 days of the installation of pump.

Well Owner Information	Well Location
Owner Name: <u>Wallace Carson</u>	Latitude: _____ Longitude: _____
Mailing Address: <u>50 Carson Ln.</u> <u>Columbus MS</u> <u>39429</u>	Method of Lat/Long (circle one): Conventional Survey, USGS quad, Hand-held GPS, Survey-grade GPS
City: _____ State: _____ Zip Code: _____	<u>N. 1/4 NE 1/4 Sec 5 Twn 3 Rng 17</u>
Telephone No. <u>(601) 736 3715</u>	Distance: _____ Direction: _____ Nearest Town: _____
	<u>6 Miles EAST of Columbus</u>

Pump Type Circle one	Power Type Circle one
Air Lift: Jet <input type="checkbox"/> <u>Submersible</u>	Diesel Engine <input type="checkbox"/> Gasoline Engine <input type="checkbox"/> Natural Gas <input type="checkbox"/>
Bucket: Piston <input type="checkbox"/> Turbine <input type="checkbox"/>	<u>Electric Motor</u> <input type="checkbox"/> Hand <input type="checkbox"/> Tractor PTO <input type="checkbox"/>
Centrifugal: Rotary <input type="checkbox"/> Flowing Well <input type="checkbox"/>	Windmill <input type="checkbox"/> Other (specify): _____
Other (specify): _____	Horse Power Rating of Motor: <u>2 HP</u>
Date Pump Installed: <u>8-8-04</u>	Setting Depth: <u>100</u> feet
Rated Pump Capacity: <u>30</u> Gallons Per Minute	Number of Stages: <u>8</u>

RECEIVED

SEP 08 2004

Pump Test Data	Method of Measuring Water Level Circle one
Date Well Tested: _____	Air Line <input type="checkbox"/> Electric Measuring Line <input type="checkbox"/> Steel Tape <input type="checkbox"/>
Static Water Level (A): <u>80</u> Feet Below Land Surface	Other (specify): _____
Pumping Water Level (B): <u>100</u> Feet Below Land Surface	For flowing well, measured shut in head: _____ feet
Drawdown [(B) - (A)]: <u>50</u> Feet Below Land Surface	Well yielded <u>30</u> GPM with a drawdown of
Test Pumping Rate: <u>30</u> Gallons Per Minute	<u>50</u> feet after <u>4</u> hours of pumping
Duration of Pump Test (minimum 4 hours): <u>4.6</u> hours	

BY: OLWR

I HEREBY CERTIFY that the above statements are true to the best of my knowledge.

JAMES WELLS Water Well Ser 0-586
 Print Name of Pump Installer and License No. (if applicable)

James Wells
 Signature of Pump Installer