

Marion  
 M 2000  
 3/28/79

MISSISSIPPI  
 BOARD OF WATER COMMISSIONERS  
 416 North State Street  
 Jackson, Mississippi 39201

WATER WELL DRILLERS LOG

3/28 1979 Hollingsworth W.S. Marion  
 date well completed firm name county well located

LANDOWNER:  
 Robert L. Linsyfelt  
 Rt 2 Columbia, Ms  
 (mailing address)

description of formations encountered	from	to
clay gravel	0	60
sand gravel	60	107

WELL LOCATION:  
 sec 16 T 30 N R 17 E  
 S W  
 24 1/2 miles N of HUB  
 (distance) (direction) (nearest town)

WELL PURPOSE:  
 (home, irrigation, municipal, industrial)

- WELL COMPLETION DATA:
- (1) diameter (inches) 2"
  - (2) total depth (feet) 107
  - (3) static water level (feet) 60 below top of ground
  - (4) casing 5 (material) 102 (depth)  
 (size) If telescope see back.
  - (5) screen 5 (length) 102 (depth to top)  
 (size) (material)
  - (6) pump 1 (HP) 9 (yield gpm)  
 elect (type power)
  - (7) electric log (yes or no)
- (organization running log)

(8) how well bottom plugged sand shale  
 DRILLERS REMARKS: good well


Miss. Board of Water Comm.

MAY 14 1979

RECEIVED

If well telescopes please sketch and show depths.

GROUND LEVEL

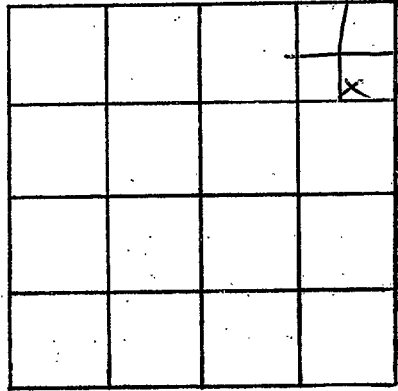

SECTION 16

Please indicate well location X.

ADDITIONAL INFORMATION

If more than one screen, show locations of each on sketch.