

MARION

M 2003

10-04-78

MISSISSIPPI
 BOARD OF WATER COMMISSIONERS
 416 North State Street
 Jackson, Mississippi 39201

WATER WELL DRILLERS LOG

10/17/78 1978 Hollinger Well Service MARION
 date well completed firm name county well located

LANDOWNER: Jerry Riley
RT 6
Columbia, MS.
 (mailing address)

description of formations encountered	from	to
<u>Red Clay</u>	<u>0</u>	<u>16</u>
	<u>16</u>	<u>40</u>

WELL LOCATION:
 sec. 4 T 30 N R 17 E
9 miles E of Columbia
 (distance) (direction) (nearest town)

WELL PURPOSE:
 (home, irrigation, municipal, industrial)

- WELL COMPLETION DATA:
- (1) diameter (inches) 2"
 - (2) total depth (feet) 40
 - (3) static water level (feet) 15 ^{below} _{above} top of ground.
 - (4) casing PVC, 30
 (material) (depth)
 (size) if telescope see back.
 - (5) screen 5, 35
 (length) (depth to top)
2, PVC
 (size) (material)
 - (6) pump 1/2, 8
 (HP) (yield gpm)
elect
 (type power)
 - (7) electric log
 (yes or no)


 (organization running log)

(8) how well bottom plugged sand
shank
 DRILLERS REMARKS: Very good

RECEIVED
 DEC 22 1978

If well telescopes please sketch and show depths.

GROUND LEVEL

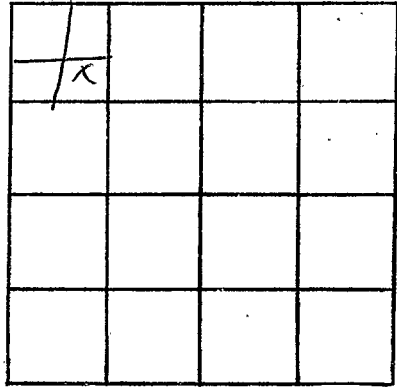

SECTION 4

Please indicate well location X.

ADDITIONAL INFORMATION

If more than one screen,
show locations of each on sketch.