

MARION  
 M 2004  
 10-6-78

MISSISSIPPI  
 BOARD OF WATER COMMISSIONERS  
 416 North State Street  
 Jackson, Mississippi 39201

WATER WELL DRILLERS LOG

TOM GRIFFITH

PLUMBING & WELL SERVICE, INC.

10-6-78 date well completed  
 1978 firm name  
 Marion county well located

LANDOWNER:

Mr. Herman Morgan  
 Rt. 2 Columbia Miss.  
 (mailing address)

description of formations encountered

from to

Top Soil	0	2
Clay	2	14
Gravel	14	29
Chalk	29	73
Clay	73	92
Chalk	92	101
Sand	101	145

WELL LOCATION:

sec. 7 T. 34 N. R. 17 E. S. 5 W. 1  
 3 miles E of Pulaski  
 (distance) (direction) (nearest town)

WELL PURPOSE:

Home  
 (home, irrigation, municipal, industrial)

WELL COMPLETION DATA:

- (1) diameter (inches) 4"
- (2) total depth (feet) 145 ft.
- (3) static water level (feet) 100 ft. <sup>below</sup>/<sub>above</sub> top of ground.
- (4) casing plastic 135 ft  
 (material) (depth)  
 4" (size) if telescope see back.
- (5) screen 10 ft. 135 ft.  
 (length) (depth to top)  
 4" plastic (size) (material)
- (6) pump 3/4 hp 25  
 (HP) (yield gpm)  
 Electric (type power)
- (7) electric log No.  
 (yes or no)

(organization running log)

- (8) how well bottom plugged  
 Back Wash Valve

DRILLERS REMARKS:


RECEIVED

DEC 13 1978

MISS. BD. OF WATER COMMISSIONERS

If well telescopes please sketch and show depths.

GROUND LEVEL

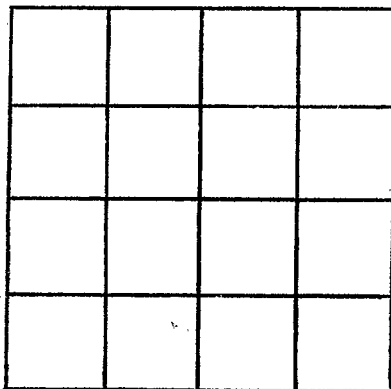

SECTION \_\_\_\_\_

Please indicate well location X.

ADDITIONAL INFORMATION

If more than one screen,  
show locations of each on sketch.