

MARION  
M  
2005

MISSISSIPPI  
BOARD OF WATER COMMISSIONERS  
416 North State Street  
Jackson, Mississippi 39201

WATER WELL DRILLERS LOG

3/8/78 1978 Don Guffie Well Marion  
date well completed first name county well located

LANDOWNER:

Mr. Herbert Norris  
Rt. 6 Box 264 Columbia Miss  
(mailing address)

description of formations encountered

from to

<u>Top Soil</u>	<u>0</u>	<u>1</u>
<u>Clay</u>	<u>1</u>	<u>25</u>
<u>Clay</u>	<u>25</u>	<u>75</u>
<u>Sand</u>	<u>75</u>	<u>100</u>

WELL LOCATION:

sec. 13 T 30 N R 17 E  
10 miles E of Columbia  
(distance) (direction) (nearest town)


WELL PURPOSE: Home  
(home, irrigation, municipal, industrial)

WELL COMPLETION DATA:

- (1) diameter (inches) 2"
- (2) total depth (feet) 100 ft.
- (3) static water level (feet) 100 ft. below top of ground.
- (4) casing plastic 90 ft.  
(material) (depth)  
2" if telescope see back.  
(size)
- (5) screen 10 ft. 90 ft.  
(length) (depth to top)  
2" plastic  
(size) (material)
- (6) pump 1 Hp   
(HP) (yield gpm)  
Electric  
(type power)
- (7) electric log no  
(yes or no)  
n/a  
(organization running log)

(8) how well bottom plugged  
B.W. Valve


DRILLERS REMARKS:

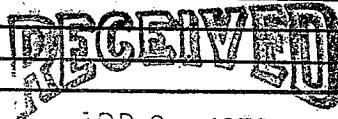

APR 27 1978

If well telescopes please sketch and show depths.

GROUND LEVEL

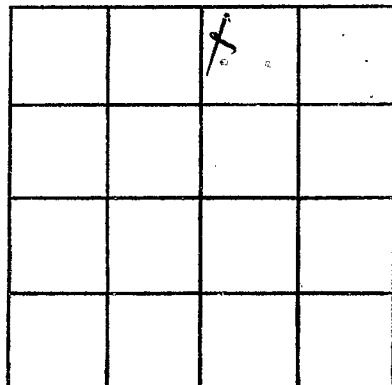

SECTION 13

Please indicate well location X.

ADDITIONAL INFORMATION

If more than one screen,  
show locations of each on sketch.