

MARION

M 2006

5-5-78

MISSISSIPPI BOARD OF WATER COMMISSIONERS 416 North State Street Jackson, Mississippi 39201

WATER WELL DRILLERS LOG

5/5/78 date well completed

19 Hollinger Well Service firm name

Marion county well located

LANDOWNER: Doran Brumby Rt 6 Box 227 Columbia, MS (mailing address)

description of formations encountered	depth	
	from	to
Sand	0	20
Chalk	20	100
Sand, gravel	100	140

WELL LOCATION:

sec. 4 T-30(N) R-17 E 10 miles E of Columbia (distance) (direction) (nearest town)

WELL PURPOSE: Home (home, irrigation, municipal, industrial)


WELL COMPLETION DATA:

- (1) diameter (inches) 2"
- (2) total depth (feet) 140
- (3) static water level (feet) 100 below top of ground.
- (4) casing PVC (material) (depth) (size) If telescope see back.
- (5) screen 5 (length) 135 (depth to top) 2 (size) PVC (material)
- (6) pump 1 (HP) 7 (yield gpm) elect (type power)
- (7) electric log (yes or no)

(organization running log)

(8) how well bottom plugged sand shark


DRILLERS REMARKS: Very good

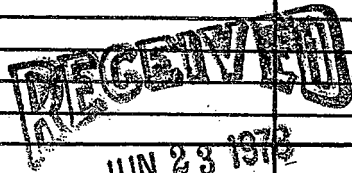

MISS. BD. OF WATER COMMISSIONERS

If well telescopes please sketch and show depths.

GROUND LEVEL

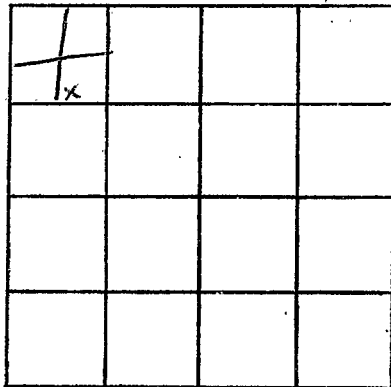

SECTION 4

Please indicate well location X.

ADDITIONAL INFORMATION

If more than one screen,
show locations of each on sketch.