

Marion
M 2009
9/14/77

MISSISSIPPI
BOARD OF WATER COMMISSIONERS
416 North State Street
Jackson, Mississippi 39201

WATER WELL DRILLERS LOG

9/14 1977 M. Hollingsworth Well Serv. Marion
date well completed firm name county well located


LANDOWNER: <u>Gordon Standiford</u>	description of formations encountered	from	to
<u>East Columbia</u>			
<u>Columbia, Ms. 39429</u> (mailing address)	<u>clay, sand, gravel</u> <u>sand</u>	<u>0</u> <u>80</u>	<u>80</u> <u>95</u>
WELL LOCATION:			
sec. <u>20</u> T. <u>31</u> N. R. <u>17</u> E <u>4</u> miles <u>SE</u> of <u>Columbia</u> (distance) (direction) (nearest town)			
WELL PURPOSE: <u>Home</u> (home, irrigation, municipal, industrial)			
WELL COMPLETION DATA:			
(1) diameter (inches) <u>2"</u>			
(2) total depth (feet) <u>95 ft.</u>			
(3) static water level (feet) <u>80</u> below top of ground. above			
(4) casing <u>pvc</u> , <u>90</u> (material) (depth) (size) if telescope see back.			
(5) screen <u>5</u> , <u>90</u> (length) (depth to top)			
<u>2"</u> (size) <u>pvc</u> (material)			
(6) pump <u>1 HP</u> , <u>9</u> (HP) (yield gpm) <u>alect</u> (type power)			
(7) electric log (yes or no)			
(organization running log)			
(8) how well bottom plugged <u>sand</u> <u>spark</u>			
DRILLERS REMARKS: <u>Good well</u>			

RECEIVED

NOV 30 1977

If well telescopes please sketch and show depths.

GROUND LEVEL

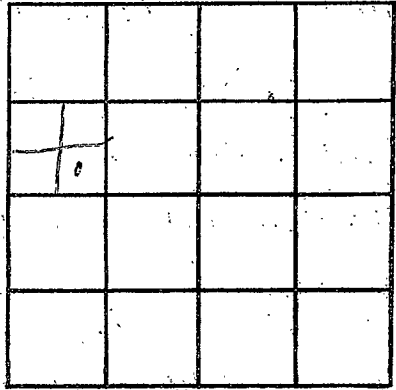

SECTION 20

Please indicate well location X:

ADDITIONAL INFORMATION

If more than one screen, show locations of each on sketch.