

MARION  
M 2010  
4-7-77

MISSISSIPPI  
BOARD OF WATER COMMISSIONERS  
416 North State Street  
Jackson, Mississippi 39201

WATER WELL DRILLERS LOG

4/17 1977 Hollinger Water Well Marion  
date well completed firm name county well located

LANDOWNER: Dwight Peavy

description of formations encountered	depth	
	from	to
Clay gravel	0	60
clay	60	80
sand	80	118

RT 6 Box 241

~~7~~ Columbia Miss  
(mailing address)

WELL LOCATION:

sec. 9 T. 30 N. R. 17 E  
S  
18 miles e of Columbia  
(distance) (direction) (nearest town)

WELL PURPOSE: Home  
(home, irrigation, municipal, industrial)

WELL COMPLETION DATA:

- (1) diameter (inches) 2"
- (2) total depth (feet) 118
- (3) static water level (feet) 60 <sup>below</sup> <sub>above</sub> top of ground.
- (4) casing pvc, 113,  
(material) (depth)  
(size) if telescope see back.
- (5) screen 5, 113  
(length) (depth to top)  
2", pvc  
(size) (material)
- (6) pump 1, 8  
(HP) (yield gpm)  
elect  
(type power)
- (7) electric log                       
(yes or no)

(organization running log)

(8) how well bottom plugged sand  
SHARIC


DRILLERS REMARKS: Very good!

APR 26 1977

MISS. Bd. OF WATER COMM

If well telescopes please sketch and show depths.

GROUND LEVEL

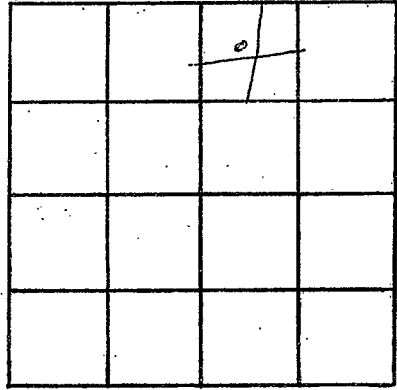

SECTION 9

Please indicate well location X.

ADDITIONAL INFORMATION

If more than one screen,  
show locations of each on sketch.