

Marion
 M 2011
 6-24-76

MISSISSIPPI
 BOARD OF WATER COMMISSIONERS
 416 North State Street
 Jackson, Mississippi 39201

WATER WELL DRILLERS LOG

6-24 1976 Hollinger Plum. Water MARION
 date well completed firm name Well county well located

LANDOWNER: Otho Johnson
 Columbia district
 Columbia, Miss.
 (mailing address)

description of formations encountered	from	to
SAND & gravel	0	40
CHALK	40	150
SAND	150	200

WELL LOCATION:
 sec. 6 T. 3 (N) R. 17 E
 6 miles east of Columbia
 (distance) (direction) (nearest town)

WELL PURPOSE: Home
 (home, irrigation, municipal, industrial)

WELL COMPLETION DATA:

(1) diameter (inches) 2"

(2) total depth (feet) 200

(3) static water level (feet) 99 below top of ground.

(4) casing PVC 200
 (material) (depth)
 N (size) if telescope see back.

(5) screen 5 195
 (length) (depth to top)
 2" (size) PVC (material)

(6) pump 1 1/2 8
 (HP) (yield gpm)
 elect (type power)

(7) electric log N
 (yes or no)
 N (organization running log)


(8) how well bottom plugged? BACK WASH DAVE

DRILLERS REMARKS: good well

MISSISSIPPI BOARD OF WATER COMMISSIONERS
 JUNE 16 1976
 MISSISSIPPI BOARD OF WATER COMMISSIONERS

If well telescopes please sketch and show depths.

GROUND LEVEL

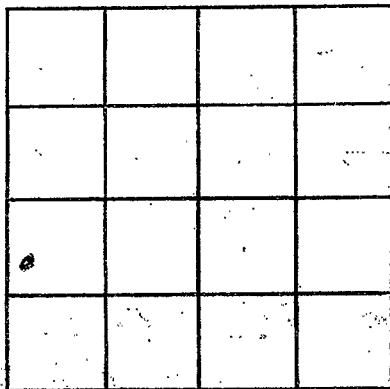

SECTION 6

Please indicate well location X.

ADDITIONAL INFORMATION

If more than one screen, show locations of each on sketch.