

Marion  
 M 2012  
 May 76

MISSISSIPPI  
 BOARD OF WATER COMMISSIONERS  
 416 North State Street  
 Jackson, Mississippi 39201

WATER WELL DRILLERS LOG

May 76 131 E. B. Sherrard Marion  
 date well completed firm name county well located

LANDOWNER:  
 James Graham  
 Columbia, Ms.  
 (mailing address)

description of formations encountered	from	to
BED CLAY	0	24'
SAND & GRAVEL	24	28'
BLUE CLAY	28	280
SHALE BLUE	280	300
BLUE CLAY	320	450
FINE SAND	450	500
COARSE SAND & PEA GRAVEL	500	515'

WELL LOCATION:  
 sec 2 T 30 N R 17 E  
 S W  
 9 miles E of Columbia  
 (distance) (direction) (nearest town)

WELL PURPOSE:  
 (home, irrigation, municipal, industrial)

- WELL COMPLETION DATA:
- (1) diameter (inches) 2"
  - (2) total depth (feet) 515'
  - (3) static water level (feet) 70' below top of ground.
  - (4) casing pl. 510' (material) (depth)  
 2" if telescope see back. (size)
  - (5) screen 5' (length) (depth to top)  
 2" pl. (size) (material)
  - (6) pump 1 (HP) 7 (yield gpm)  
 elec. (type power)
  - (7) electric log (yes or no)
  - (8) how well bottom plugged B.W.V.


DRILLERS REMARKS:

RECEIVED

OCT 18 1976

If well telescopes please sketch and show depths.

GROUND LEVEL

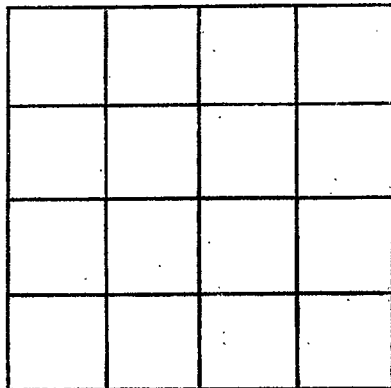

SECTION \_\_\_\_\_

Please indicate well location X.

ADDITIONAL INFORMATION

If more than one screen, show locations of each on sketch.