

Marion  
 M 2013  
 3/5/76

MISSISSIPPI  
 BOARD OF WATER COMMISSIONERS  
 416 North State Street  
 Jackson, Mississippi 39201

WATER WELL DRILLERS LOG

GRINER - GINN

3-5 1976  
 date well completed

firm name

Marion  
 county well located


LANDOWNER:	description of formations encountered	from	to
Stella Fortenberry	Top Soil	0	1
Rt. 2 Foxworth, Miss (mailing address)	Clay	1	12
	SAND	12	45
<b>WELL LOCATION:</b>			
sec. <u>31</u> T. <u>3</u> N R. <u>17</u> W			
<u>1</u> miles <u>N</u> of <u>Spring Lake</u>			
(distance) (direction) (nearest town)			
<b>WELL PURPOSE:</b> <u>Home</u>			
(home, irrigation, municipal, industrial)			
<b>WELL COMPLETION DATA:</b>			
(1) diameter (inches) <u>2"</u>			
(2) total depth (feet) <u>55</u>			
(3) static water level (feet) <u>20</u> below top of ground.			
(4) casing <u>PVC</u> , <u>45</u> (material) (depth)			
<u>2 1/2</u> if telescope see back. (size)			
(5) screen <u>10'</u> , <u>45</u> (length) (depth to top)			
<u>2"</u> , <u>PVC</u> (size) (material)			
(6) pump <u>1/2</u> , <u>13</u> ✓ (HP) (yield gpm)			
<u>plc</u> (type power)			
(7) electric log <u>NO</u> (yes or no)			
(organization running log)			
(8) how well bottom plugged <u>B.W. Valve</u>			
DRILLERS REMARKS:			

RECEIVED  
 OCT 12 1976

MISS. BD. OF WATER COMM.

If well telescopes please sketch and show depths.

GROUND LEVEL

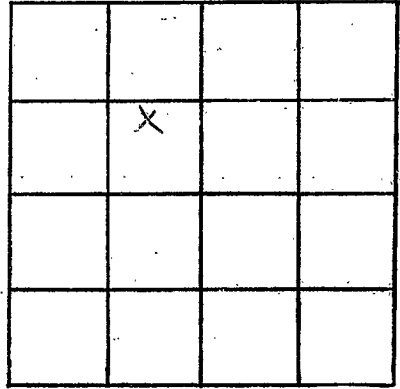

SECTION 31

Please indicate well location X.

ADDITIONAL INFORMATION

If more than one screen, show locations of each on sketch.