

Marion  
 M 2014  
 41 76

MISSISSIPPI  
 BOARD OF WATER COMMISSIONERS  
 416 North State Street  
 Jackson, Mississippi 39201

WATER WELL DRILLERS LOG

April 19 76 E.B. Sheppard & Marion  
 date well completed firm name county/well located

LANDOWNER:	description of formations encountered	from	to
Richard Peavy Columbia, MS. (mailing address)	BLUE CLAY SAND + SMALL PIEA GRAVEL	0	200 240'
<b>WELL LOCATION:</b>			
sec 19 T 30 N R 17 E S W 6 miles SE of Columbia (distance) (direction) (nearest town)			
<b>WELL PURPOSE:</b>			
(home, irrigation, municipal, industrial)			
<b>WELL COMPLETION DATA:</b>			
(1) diameter (inches) 2"			
(2) total depth (feet) 240'			
(3) static water level (feet) 110 below top of ground.			
(4) casing pl. 235' (material) (depth)			
2" (size) If telescope see back.			
(5) screen 5' (length) (depth to top)			
2" pl. (size) (material)			
(6) pump 1/2 (HP) 7 (yield gpm)			
elec. (type power)			
(7) electric log (yes or no)			
(organization running log)			
(8) how well bottom plugged			
DRILLERS REMARKS:			


RECEIVED

OCT 18 1976

MISS. BD. OF WATER COMMISSIONERS

If well telescopes please sketch and show depths.

GROUND LEVEL

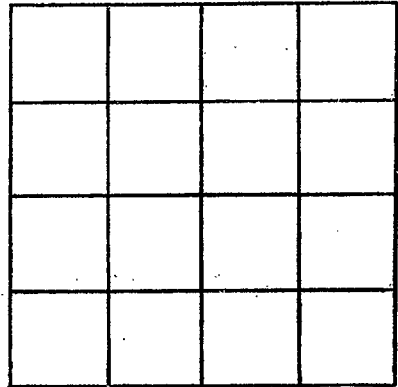

SECTION \_\_\_\_\_

Please indicate well location X.

ADDITIONAL INFORMATION

If more than one screen, show locations of each on sketch.