

Marion
 M 2016
 3/76

MISSISSIPPI
 BOARD OF WATER COMMISSIONERS
 416 North State Street
 13V Jackson, Mississippi 39201

WATER WELL DRILLERS LOG

March 76 E.B. Sheppard (Marion)
 date well completed firm name county well located


LANDOWNER:	description of formations encountered	from	to
Calvin Noree Columbia, Ms. (mailing address)	BED CLAY CLAY CLAY SAND & PEAT / etc.	0 30 180	30 180 230
WELL LOCATION:			
sec 21 T 30 N R 17 E S W 8 miles SE of Columbia (distance) (direction) (nearest town)			
WELL PURPOSE:			
(home) irrigation, municipal, industrial			
WELL COMPLETION DATA:			
(1) diameter (inches) 2"			
(2) total depth (feet) 230'			
(3) static water level (feet) 140' below top of ground.			
(4) casing pl. 225' (material) (depth)			
2" (size) if telescope see back.			
(5) screen 5' (length) (depth to top)			
2" (size) pl. (material)			
(6) pump 2 (HP) 6 (yield gpm)			
elec. (type power)			
(7) electric log (yes or no) (no)			
(organization running log)			
(8) how well bottom plugged BWV			
DRILLERS REMARKS:			

RECEIVED
 OCT 18 1976

MISS. Bd. OF WATER COMMISSIONERS

If well telescopes please sketch and show depths.

GROUND LEVEL

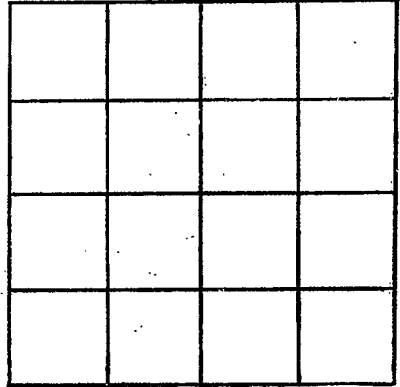

SECTION _____

Please indicate well location X.

ADDITIONAL INFORMATION

If more than one screen, show locations of each on sketch.