

Marion  
M 2017  
1-4-76

MISSISSIPPI  
 BOARD OF WATER COMMISSIONERS  
 416 North State Street  
 Jackson, Mississippi 39201

WATER WELL DRILLERS LOG

1-4 date well completed     1976 Hollinger Plumb + Water Well firm name     Marion county well located

LANDOWNER: Bennie M. Cook  
Rt. 3 East Columbin  
Columbin, Miss. 39429  
 (mailing address)

description of formations encountered	from	to
CLAY	0	35
SAND & GRAVEL	35	65
CHALK	65	70
SAND + GRAVEL	70	91

WELL LOCATION:  
 sec 21 T 3 (N) R 19 (W)  
4-5 miles NORTH of Hub  
 (distance) (direction) (nearest town)

WELL PURPOSE: BUSINESS  
 (home, irrigation, municipal, industrial)

- WELL COMPLETION DATA:
- (1) diameter (inches) 2"
  - (2) total depth (feet) 91 ft.
  - (3) static water level (feet) 35 below above top of ground.
  - (4) casing 2" pvc.  
 (material) (depth)  
No if telescope see back.  
 (size)
  - (5) screen 5 ft. 86  
 (length) (depth to top)  
2" pvc.  
 (size) (material)
  - (6) pump 1 12  
 (HP) (yield gpm)  
elect.  
 (type power)
  - (7) electric log N  
 (yes or no)  
N  
 (organization running log)
  - (8) how well bottom plugged sand  
shark

DRILLERS REMARKS: excellent well


DISCOVERED  
 15 11

FEB 11 1976

MISS. Bd. OF WATER COMMISSIONERS

If well telescopes please sketch and show depths.

GROUND LEVEL

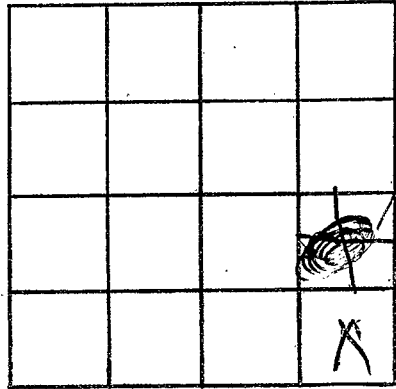

SECTION \_\_\_\_\_

Please indicate well location X.

ADDITIONAL INFORMATION

If more than one screen, show locations of each on sketch.