

Marion  
 M 2018  
 Jan. 1976

MISSISSIPPI  
 BOARD OF WATER COMMISSIONERS  
 416 North State Street  
 Jackson, Mississippi 39201

WATER WELL DRILLERS LOG

JAN. 1976 E. B. SHEPARD MARION  
 date well completed firm name county well located

LANDOWNER:

HAROLD BAUGHMAN  
 Columbia, Miss.  
 (mailing address)

description of formations encountered

from to

HARD RED CLAY	0	25
SANDY RED "	25	40
COARSE SAND & GRAVEL	40	56

WELL LOCATION:

?  
 about  
 4 mi.

sect. 12 T. 3 N R. 17 E  
 S W  
 10 miles E of Columbia  
 (distance) (direction) (nearest town)

WELL PURPOSE:

(home, irrigation, municipal, industrial)

WELL COMPLETION DATA:

- (1) diameter (inches) 2"
- (2) total depth (feet) 56
- (3) static water level (feet) 40 below above top of ground.
- (4) casing pl. 51 (material) (depth)  
 2" (size) if telescope see back.
- (5) screen 5' (length) (depth to top)  
 2" (size) pl. (material)
- (6) pump 1 (HP) 7 (yield gpm)  
 elec. (type power)
- (7) electric log (yes or no) (no)

(organization running log)

(8) how well bottom plugged BWV


DRILLERS REMARKS:

RECEIVED

OCT 18 1976

If well telescopes please sketch and show depths.

GROUND LEVEL

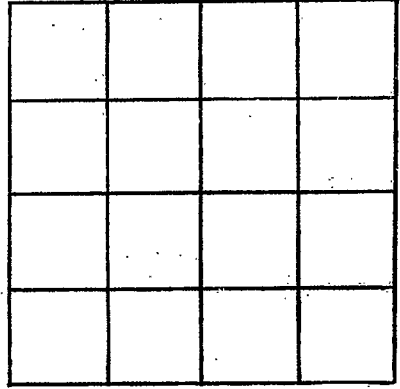

SECTION \_\_\_\_\_

Please indicate well location X.

ADDITIONAL INFORMATION

If more than one screen,  
show locations of each on sketch.