


**MARION**  
**M 2019**  
**11-3-75**

**MISSISSIPPI**  
**BOARD OF WATER COMMISSIONERS**  
 416 North State Street  
 Jackson, Mississippi 39201

**WATER WELL DRILLERS LOG**

11-3 1975 *Yunis & Hester* **MARION**  
 date well completed firm name county well located

| LANDOWNER:  | description of formations encountered | from      | to        |
|---|---------------------------------------|-----------|-----------|
|   |                                       |           |           |
| <i>Archie Lee Tuttrill</i>  | <i>Top Soil</i>                       | <i>0</i>  | <i>1</i>  |
| <i>Ht. 2 Box 248</i><br>(mailing address)   | <i>Clay</i>                           | <i>1</i>  | <i>3</i>  |
| <i>City</i>   | <i>Gravel</i>                         | <i>3</i>  | <i>9</i>  |
| WELL LOCATION: <i>3N 2 17W</i>  | <i>Sand</i>                           | <i>9</i>  | <i>21</i> |
| sec. <i>4</i> T. <i>4N</i> R. <i>17E</i>  | <i>Chalk</i>                          | <i>21</i> | <i>30</i> |
| <i>4</i> miles <i>E</i> of <i>Columbia</i><br>(distance) (direction) (nearest town) | <i>Sand</i>                           | <i>30</i> | <i>40</i> |
| WELL PURPOSE: <i>Water</i><br>(home, irrigation, municipal, industrial)             |                                       |           |           |
| WELL COMPLETION DATA:   |                                       |           |           |
| (1) diameter (inches) <i>2"</i>   |                                       |           |           |
| (2) total depth (feet) <i>40</i>  |                                       |           |           |
| (3) static water level (feet) <i>15</i> below top of ground                         |                                       |           |           |
| (4) casing <i>PVC</i> , <i>30</i><br>(material) (depth)                             |                                       |           |           |
| <i>2"</i> if telescope see back.<br>(size)  |                                       |           |           |
| (5) screen <i>10</i> , <i>30</i><br>(length) (depth to top)                         |                                       |           |           |
| <i>2"</i> , <i>PVC</i><br>(size) (material)   |                                       |           |           |
| (6) pump <i>NO</i> <i>PUMP</i><br>(HP) (yield gpm)                                  |                                       |           |           |
| (type power)  |                                       |           |           |
| (7) electric log <i>NO</i><br>(yes or no)   |                                       |           |           |
| (organization running log)  |                                       |           |           |
| (8) how well bottom plugged <i>D.W. Value</i>                                       |                                       |           |           |
| DRILLERS REMARKS:   |                                       |           |           |

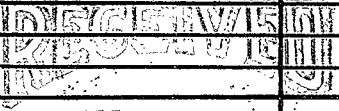

**MAR 20 1976**

If well telescopes please sketch and show depths.

GROUND LEVEL

|  |  |  |    |
|--|--|--|----|
|  |  |  | 11 |
|  |  |  |    |
|  |  |  |    |
|  |  |  |    |

SECTION \_\_\_\_\_

Please indicate well location X.

ADDITIONAL INFORMATION

If more than one screen, show locations of each on sketch.