

Marion
M 2000
9/75

MISSISSIPPI
BOARD OF WATER COMMISSIONERS
416 North State Street
Jackson, Mississippi 39201

WATER WELL DRILLERS LOG

Sept. 1975 E.B. Sheward Marion
date well completed firm name county well located

LANDOWNER:
Jimmy Breakfield
Columbia, Ms.
(mailing address)

description of formations encountered
SAND & GRAVEL
from 0 to 28'

WELL LOCATION:
sec. 5 T 3 N R 17 E 13V
4 1/2 miles E Columbia
(distance) (direction) (nearest town)

WELL PURPOSE:
(home) irrigation, municipal, industrial

- WELL COMPLETION DATA:
- (1) diameter (inches) 2"
 - (2) total depth (feet) 28'
 - (3) static water level (feet) 18' ^{below} above top of ground.
 - (4) casing pl. 23' (material) (depth)
2" if telescope see back. (size)
 - (5) screen 5' (length) (depth to top)
2" (size) pl. (material)
 - (6) pump 1/3 (HP) 8 (yield gpm)
E (type power)
 - (7) electric log (yes or no) no
(organization running log)
 - (8) how well bottom plugged BWV


REGISTERED
DIS
DEC-5 1975

DRILLERS REMARKS:

MISS. Bd. OF WATER COMMISSIONERS

If well telescopes please sketch and show depths.

GROUND LEVEL

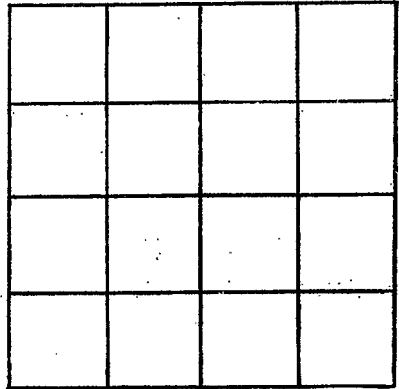

SECTION _____

Please indicate well location X.

ADDITIONAL INFORMATION

If more than one screen,
show locations of each on sketch.