

Marion  
M 2021  
8-75

MISSISSIPPI  
BOARD OF WATER COMMISSIONERS  
416 North State Street  
Jackson, Mississippi 39201

WATER WELL DRILLERS LOG

August 75 E. B. Skerrard Marion  
date well completed firm name county well located

LANDOWNER:  
J. B. Breakfield  
Columbia, Ms.  
(mailing address)

description of formations encountered	from	to
LOOSE RED SANDY CLAY	0	60'
COARSE SAND	60	86'

WELL LOCATION:  
sec. 11 T. 3 N. R. 17 E. 13V  
8 miles E of Columbia  
(distance) (direction) (nearest town)

WELL PURPOSE:  
(home) Irrigation, municipal, industrial


- WELL COMPLETION DATA:
- (1) diameter (inches) 2"
  - (2) total depth (feet) 86'
  - (3) static water level (feet) 55' below top of ground.
  - (4) casing (material) pl. (depth) 81'
  - 2" if telescope see back.  
(size)
  - (5) screen 5' (length) (depth to top)
  - 2" (size) pl. (material)
  - (6) pump 7 (HP) (yield gpm)
  - E (type power)
  - (7) electric log (yes or no)
  - (organization running log)
  - (8) how well bottom plugged Blwv

DRILLERS REMARKS:

DEC 5 1975  
MISS. BO. OF WATER COMMISSIONERS

If well telescopes please sketch and show depths.

GROUND LEVEL

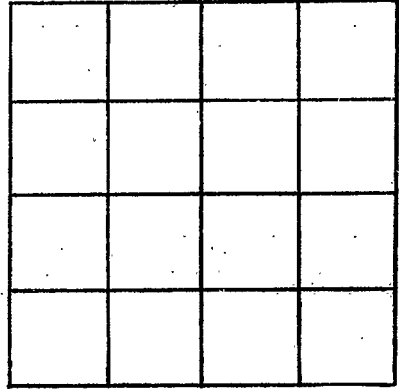

SECTION \_\_\_\_\_

Please indicate well location X.

ADDITIONAL INFORMATION

If more than one screen,  
show locations of each on sketch.