

MISSISSIPPI DEPARTMENT OF NATURAL RESOURCES
Bureau of Land and Water Resources
 Southport Mall
 P.O. Box 10631
 Jackson, Mississippi 39209
WATER WELL DRILLERS LOG

Marion
M
222

3-1 1983 Hollins Marion
 date well completed firm name county well located

LANDOWNER: Gene Saurin
Rt 7 Box 327
Columbia, Miss
 (mailing address)

description of formations encountered	depth	
	from	to
<u>SAND, clay</u>	<u>0</u>	<u>10</u>
<u>SAND, clay, chalk</u>	<u>10</u>	<u>40</u>
<u>fine gravel</u>	<u>40</u>	<u>50</u>

WELL LOCATION:
 sec. 19 T 30 N R 17 E
6 miles SE of Columbia
 (distance) (direction) (nearest town)

WELL PURPOSE:
 (home, irrigation, municipal, industrial)

- WELL COMPLETION DATA:
- (1) diameter (inches) 2"
 - (2) total depth (feet) 50
 - (3) static water level (feet) 10 below above top of ground.
 - (4) casing pvc, 45
 (material) (depth)
 - (size) if telescope see back.
 - (5) screen 5, 45
 (length) (depth to top)
 - 2"
 (size) (material)
 - (6) pump 1/2, 6
 (HP) (yield gpm)
 - slat
 (type power)
 - (7) electric log _____
 (yes or no)
 - _____ (organization running log)


(8) how well bottom plugged SAND
SHREK

DRILLERS REMARKS: Very good well

DEPT. OF NATURAL RESOURCES
 BUREAU OF LAND & WATER RESOURCES
 SEP 27 1983
RECEIVED

If well telescopes please sketch and show depths.

GROUND LEVEL

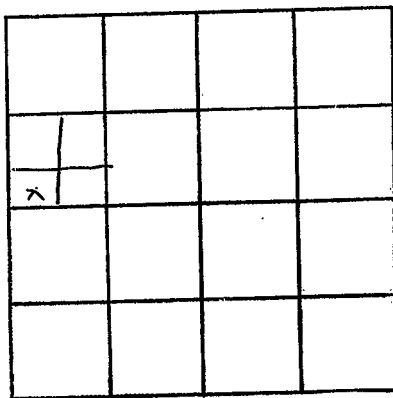

SECTION 19

Please indicate well location X.

ADDITIONAL INFORMATION

If more than one screen,
show locations of each on sketch.