

Marion  
M  
2024

MISSISSIPPI DEPARTMENT OF NATURAL RESOURCES  
Bureau of Land and Water Resources  
Southport Mall  
P.O. Box 10631  
Jackson, Mississippi 39209  
WATER WELL DRILLERS LOG

6/28/82 19 Braden Pump and Well Service, Marion  
date well completed firm name Inc. county well located

LANDOWNER: <u>Bernice Oglesbee</u>	description of formations encountered	from	to
<u>5600 Keele St.</u>			
<u>Cedar Stone Apts.</u>	Sand	20	40
<u>Jackson, Ms.</u>	Clay	40	60
<u>(mailing address)</u>	gravel	60	80
<u>WELL LOCATION:</u>	Sand	80	90
<u>sec 3 T 3 N / R 17 E -</u> <u>S W</u>	Clay	90	140
<u>7 miles E of Columbia</u>	Sand	140	200
<u>(distance) (direction) (nearest town)</u>	Clay	200	250
<u>WELL PURPOSE: Home</u>	Sand	250	300
<u>(home, irrigation, municipal, industrial)</u>			
<u>WELL COMPLETION DATA:</u>			
(1) diameter (inches) <u>2"</u>			
(2) total depth (feet) <u>300 ft.</u>			
(3) static water level (feet) <u>150</u> below top of ground.			
(4) casing <u>PVC</u> , <u>290'</u> (material) (depth)			
<u>2"</u> (size) if telescope see back.			
(5) screen <u>10"</u> , <u>290'</u> (length) (depth to top)			
<u>2"</u> , <u>PVC underbar</u> (size) (material)			
(6) pump <u>1 1/2 H.P.</u> , <u>4gpm</u> (HP) (yield gpm)			
<u>220V</u> (type power)			
(7) electric log <u>No</u> (yes or no)			
<u>(organization running log)</u>			
(8) how well bottom plugged: <u>sand shark</u>			

DRILLERS REMARKS:  
No tail pipe


DEPT. OF NATURAL RESOURCES  
BUREAU OF LAND & WATER RESOURCES

JAN 13 1983

RECEIVED

If well telescopes please sketch and show depths.

GROUND LEVEL

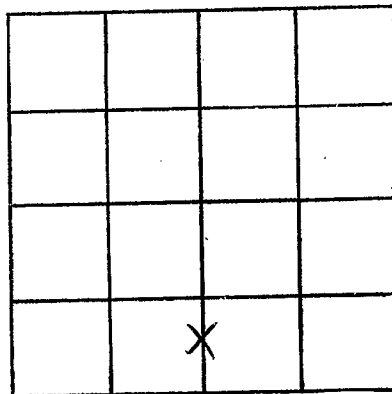

SECTION 3

Please indicate well location X.

ADDITIONAL INFORMATION

If more than one screen,  
show locations of each on sketch.