

Marion
M
2025

MISSISSIPPI DEPARTMENT OF NATURAL RESOURCES
 Bureau of Land and Water Resources
 Southport Mall
 P.O. Box 10631
 Jackson, Mississippi 39209
WATER WELL DRILLERS LOG

Aug 4 1982 Cochran Drilling Marion
 date well completed firm name county well located
Service

LANDOWNER:
Jimmy D Raugdrill
Rt. 12 Hattiesburg
 (mailing address)

description of formations encountered	from	to
	<u>TOP Soil</u>	<u>0</u>
<u>Red clay</u>	<u>2</u>	<u>6</u>
<u>Red Sand</u>	<u>6</u>	<u>18</u>
<u>Gray clay</u>	<u>18</u>	<u>140</u>
<u>Blue clay</u>	<u>140</u>	<u>190</u>
<u>Sand</u>	<u>190</u>	<u>997</u>
<u>Blue clay</u>	<u>197</u>	<u>210</u>
<u>Sand</u>	<u>210</u>	<u>260</u>

WELL LOCATION:
 sec. 3 T. 30 N. R. 17 E.
9 miles SW of Olch
 (distance) (direction) (nearest town)

WELL PURPOSE:
 (home, irrigation, municipal, industrial)


- WELL COMPLETION DATA:
- (1) diameter (inches) 4"
 - (2) total depth (feet) 260'
 - (3) static water level (feet) 170' below top of ground.
 - (4) casing PVC 250'
 (material) (depth)
 - (size) If telescope see back.
 - (5) screen 10' 250'
 (length) (depth to top)
 - (size) 4" (material) PVC
 - (6) pump 1 Sub 9
 (HP) (yield gpm)
 - (type power) Elec
 - (7) electric log no
 (yes or no)
 - (organization running log)
 - (8) how well bottom plugged Value

DRILLERS REMARKS:

DEPT. OF NATURAL RESOURCES
 BUREAU OF LAND & WATER RESOURCES
 OCT - 4 1982
RECEIVED

If well telescopes please sketch and show depths.

GROUND LEVEL

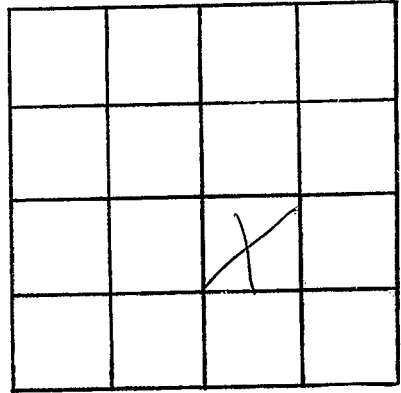

SECTION 3

Please indicate well location X.

ADDITIONAL INFORMATION

If more than one screen, show locations of each on sketch.