

MISSISSIPPI DEPARTMENT OF NATURAL RESOURCES

Bureau of Land and Water Resources

Southport Mall

P.O. Box 10631

Jackson, Mississippi 39209

WATER WELL DRILLERS LOG

Marion
M
2026

4-26-1982 date well completed Hollinger firm name Marion county well located

LANDOWNER:	description of formations encountered	from	to
R. J. Nilburn			
East Columbia	sand	0	150
Columbia, Ms.	chalk	150	220
(mailing address)	gravel, coarse sand	150	150
WELL LOCATION:			
sec. 17 T 30 N R 17 E			
5 miles north of Hub			
(distance) (direction) (nearest town)			
WELL PURPOSE:			
(home, irrigation, municipal, industrial)			
WELL COMPLETION DATA:			
(1) diameter (inches) 4"			
(2) total depth (feet) 250			
(3) static water level (feet) 150 below top of ground.			
(4) casing PVC, 240, (material) (depth)			
(size) If telescope see back.			
(5) screen 10, 240 (length) (depth to top)			
4, PVC (size) (material)			
(6) pump 1, 10 (HP) (yield gpm)			
elect (type power)			
(7) electric log (yes or no)			
(organization running log)			
(8) how well bottom plugged sand shark			
DRILLERS REMARKS: good well			

copy


DEPT. OF NATURAL RESOURCES
BUREAU OF LAND & WATER RESOURCES

NOV 17 1982

RECEIVED

If well telescopes please sketch and show depths.

GROUND LEVEL

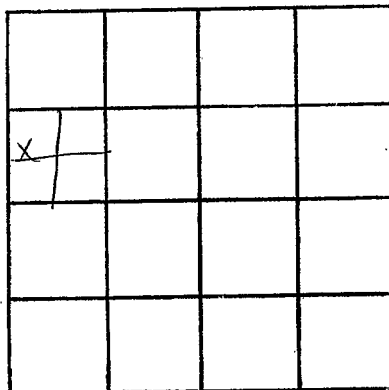

SECTION 17

Please indicate well location X.

ADDITIONAL INFORMATION

If more than one screen, show locations of each on sketch.