

MISSISSIPPI DEPARTMENT OF NATURAL RESOURCES  
 Bureau of Land and Water Resources  
 Southport Mall  
 P.O. Box 10631  
 Jackson, Mississippi 39209  
**WATER WELL DRILLERS LOG**

Marion  
M  
2028

8-9-82 19 Bradley Pump & Well Service Marion  
 date well completed firm name county well located

LANDOWNER: Earl Brakfield  
Rt. 6, Box 273  
Columbia, ms. 39429  
 (mailing address)

description of formations encountered	from	to
Clay	0	10
sand	10	15
clay	15	40
sand	40	45
clay	45	117
sand	117	140

WELL LOCATION:  
 sec. 3 T. 3 N R. 17 E  
7 miles East of Columbia  
 (distance) (direction) (nearest town)

WELL PURPOSE: home  
 (home, irrigation, municipal, industrial)

WELL COMPLETION DATA:

- (1) diameter (inches) 2"
- (2) total depth (feet) 140'
- (3) static water level (feet) 55 below above top of ground.
- (4) casing PVC, 120'  
 (material) (depth)  
2"  
 (size) If telescope see back.
- (5) screen 20', 120'  
 (length) (depth to top)  
2", PVC Under  
 (size) (material) Bar
- (6) pump 1hp., 8  
 (HP) (yield gpm)  
220V 1φ  
 (type power)
- (7) electric log no  
 (yes or no)  
 (organization running log)


(8) how well bottom plugged back-wash check

DRILLERS REMARKS: no tail-pipe

DEPT. OF NATURAL RESOURCES  
 BUREAU OF LAND & WATER RESOURCES  
 RECEIVED  
 SEP 30 1982

If well telescopes please sketch and show depths.

GROUND LEVEL

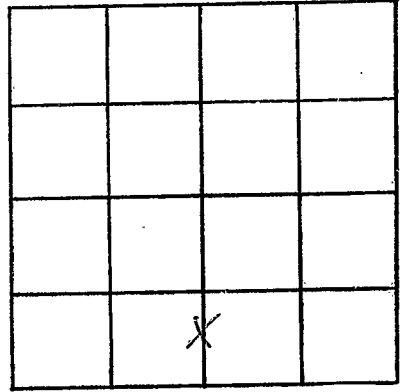

SECTION 3

Please indicate well location X.

ADDITIONAL INFORMATION

If more than one screen,  
show locations of each on sketch.