

*Marion*  
 M  
 2029

MISSISSIPPI  
 BOARD OF WATER COMMISSIONERS  
 416 North State Street  
 Jackson, Mississippi 39201

WATER WELL DRILLERS LOG

TOM GRIFFITH

3/16/92  
 date well completed

19 *1982* *MISSISSIPPI* & WELL SERVICE, INC.  
 firm name

*Marion*  
 county well located


LANDOWNER:	description of formations encountered	from	to
<i>Emil Bullback</i>	<i>Topsoil</i>	<i>0</i>	<i>1</i>
<i>305 Broad St.</i>	<i>Clay</i>	<i>1</i>	<i>60</i>
<i>Columbia, MS</i>	<i>Sand</i>	<i>60</i>	<i>67</i>
(mailing address) <i>39429</i>	<i>Clay</i>	<i>67</i>	<i>180</i>
WELL LOCATION:	<i>Sand</i>	<i>180</i>	<i>240</i>
sec. <i>17</i> T. <i>3</i> <i>N</i> R. <i>17</i> E			
<i>10</i> miles <i>E</i> of <i>Columbia</i>			
(distance) (direction) (nearest town)			
WELL PURPOSE: <i>Home</i>			
(home, irrigation, municipal, industrial)			
WELL COMPLETION DATA:			
(1) diameter (inches) <i>4"</i>			
(2) total depth (feet) <i>240'</i>			
(3) static water level (feet) <i>170</i> below top of ground.			
(4) casing <i>PVC, 220'</i>			
(material) (depth)			
<i>4"</i> (size) if telescope see back.			
(5) screen <i>20, 220'</i>			
(length) (depth to top)			
<i>4</i> (size) <i>PVC</i> (material)			
(6) pump <i>3/4, 10</i>			
(HP) (yield gpm)			
<i>elec</i> (type power)			
(7) electric log <i>No</i>			
(yes or no)			
<i>MA</i> (organization running log)			
(8) how well bottom plugged <i>BCN</i>			
DRILLERS REMARKS:			

DEPT. OF NATURAL RESOURCES  
 BUREAU OF LAND & WATER RESOURCES

JUN - 9 1982  
 RECEIVED

If well telescopes please sketch and show depths.

GROUND LEVEL

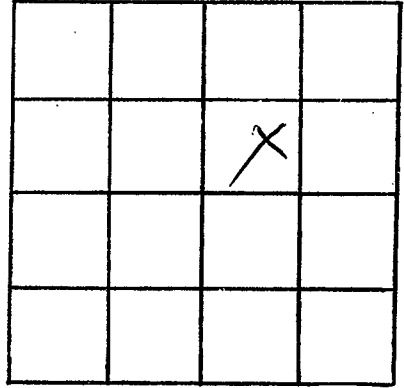

SECTION 17

Please indicate well location X.

ADDITIONAL INFORMATION

If more than one screen,  
show locations of each on sketch.