

Manawa
M
2030

MISSISSIPPI
 BOARD OF WATER COMMISSIONERS
 416 North State Street
 Jackson, Mississippi 39201

WATER WELL DRILLERS LOG

TOM GRIFFITH
 DRILLING & WELL SERVICE, INC.
 firm name

12-17-82 1982 date well completed
Manawa county well located

LANDOWNER: <u>Ken Stockdale</u>	description of formations encountered	from	to
<u>A+ 2</u>			
<u>Columbia MS 39429</u> (mailing address)	<u>0 - clay</u>	<u>0</u>	<u>50</u>
	<u>sand</u>	<u>50</u>	<u>55</u>
	<u>clay</u>	<u>55</u>	<u>160</u>
	<u>100 - 120</u>		
	<u>sand</u>	<u>160</u>	<u>180</u>
WELL LOCATION:			
sec. <u>20</u> T <u>3</u> S <u>N</u> R. <u>17</u> E <u>W</u>			
<u>0.7</u> miles <u>East</u> of <u>Columbia</u> (distance) (direction) (nearest town)			
WELL PURPOSE: <u>Home</u> (home, irrigation, municipal, industrial)			
WELL COMPLETION DATA:			
(1) diameter (inches) <u>4</u>			
(2) total depth (feet) <u>180</u>			
(3) static water level (feet) <u>120</u> below top of ground.			
(4) casing <u>PVC</u> <u>180</u> (material) (depth)			
(size) if telescope see back.			
(5) screen <u>20</u> <u>160</u> (length) (depth to top)			
<u>4</u> <u>109/10+</u> (size) (material)			
(6) pump <u>3/4</u> <u>10</u> (HP) (yield gpm)			
<u>Electric</u> (type power)			
(7) electric log <u>no</u> (yes or no)			
(organization running log)			
(8) how well bottom plugged <u>bwB</u>			
DRILLERS REMARKS:			


DEPT. OF NATURAL RESOURCES
 BUREAU OF LAND & WATER RESOURCES

JUN - 9 1982

RECEIVED

If well telescopes please sketch and show depths.

GROUND LEVEL

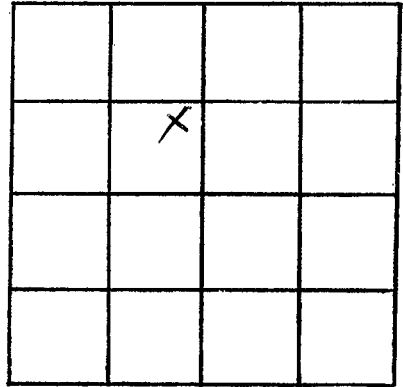

SECTION 70

Please indicate well location X.

ADDITIONAL INFORMATION

If more than one screen,
show locations of each on sketch.