

MARION
M 2033
5-2-81

MISSISSIPPI
 BOARD OF WATER COMMISSIONERS
 416 North State Street
 Jackson, Mississippi 39201

WATER WELL DRILLERS LOG

5/2/81 19 Tom Smith Well Serv. Marion
 date well completed firm name county well located


LANDOWNER: CALVIN
HOTARD
RT 2 COLUMBIA
 (mailing address)

description of formations encountered	from	to
top soil	0	5
Red clay	5	20
sand	20	45
clay	45	180
shale	180	265

WELL LOCATION:
 sec. 8 T 3 N R 17 E
8 miles E of Columbia
 (distance) (direction) (nearest town)

WELL PURPOSE: Home
 (home, irrigation, municipal, industrial)


- WELL COMPLETION DATA:
- diameter (inches) 4
 - total depth (feet) 265
 - static water level (feet) 150 below top of ground.
 - casing 4" pipe (material) 265' (depth)
 If telescope see back.
 - screen 20 Feet (length) (depth to top)
4" (size) Black 10510 (material)
 - pump 1 (HP) 12 (yield gpm)
elec. (type power)
 - electric log no (yes or no)
n/a (organization running log)
 - how well bottom plugged B, W, U

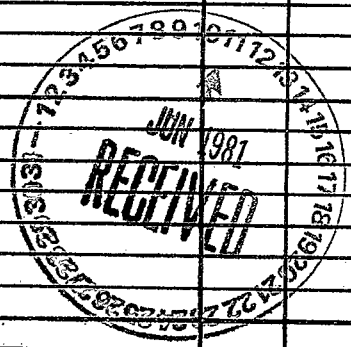

DRILLERS REMARKS:

If well telescopes please sketch and show depths.

GROUND LEVEL

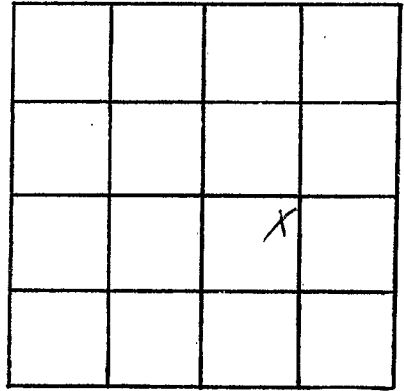

SECTION 6

Please indicate well location X.

ADDITIONAL INFORMATION

If more than one screen,
show locations of each on sketch.