

MARION
M 2634

MISSISSIPPI
BOARD OF WATER COMMISSIONERS
416 North State Street
Jackson, Mississippi 39201

WATER WELL DRILLERS LOG

5/27/81

5-27-88

19

TOM GRIFITH

MARION

date well completed

firm name

county well located

LANDOWNER:

TOM FORBES

Route 7 Columbia
(mailing address)

description of formations encountered

from

to

CHALK

1 170

SAND

170 260


WELL LOCATION:

sec 22 T 3 N R 17 E
S W
7 miles E of Columbia
(distance) (direction) (nearest town)

WELL PURPOSE: HOME
(home, irrigation, municipal, industrial)

WELL COMPLETION DATA:

- (1) diameter (inches) 1 1/2"
- (2) total depth (feet) 260
- (3) static water level (feet) 160 below above top of ground.
- (4) casing 4" 240
(material) (depth)
1 1/2" (size) (If telescope see back.)
- (5) screen 4'20" 240
(length) (depth to top)
4" PLASTIC
(size) (material)
- (6) pump 1 12
(HP) (yield gpm)
FLI
(type power)
- (7) electric log NO
(yes or no)
n/a
(organization running log)
- (8) how well bottom plugged BLWV

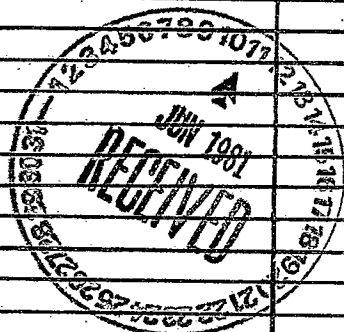

DRILLERS REMARKS:

... please
show depths.

GROUND LEVEL

| | | | |
|--|---|--|--|
| | | | |
| | | | |
| | X | | |
| | | | |

SECTION 22

Please indicate well location X.

ADDITIONAL INFORMATION

If more than one screen,
show locations of each on sketch.