

MARION
 M 2035
 3-10-81

MISSISSIPPI
 BOARD OF WATER COMMISSIONERS
 416 North State Street
 Jackson, Mississippi 39201

WATER WELL DRILLERS LOG

3-10 1981 Hollinsworth MARION
 date well completed firm name county well located

LANDOWNER: <u>Sherry Bullback</u>	description of formations encountered	from	to
<u>East Columbia</u>	SAND gravel	0	100
<u>Columbia, MS</u> (mailing address)	CLAY	100	200
WELL LOCATION:	SAND, PERGRAVEL	200	248
sec. <u>17</u> T- <u>3</u> N R- <u>17</u> E			
<u>6</u> miles <u>E</u> of <u>Columbia</u>			
(distance) (direction) (nearest town)			
WELL PURPOSE: <u>Home</u> (home, irrigation, municipal, industrial)			
WELL COMPLETION DATA:			
(1) diameter (inches) <u>2</u>			
(2) total depth (feet) <u>248</u>			
(3) static water level (feet) <u>100</u> <u>below</u> top of ground.			
(4) casing <u>PVC</u> , <u>238</u> (material) (depth)			
(size) If telescope see back.			
(5) screen <u>10</u> , <u>238</u> (length) (depth to top)			
<u>2</u> , <u>PVC</u> (size) (material)			
(6) pump <u>2</u> , <u>12</u> (HP) (yield gpm)			
<u>elect</u> (type power)			
(7) electric log _____ (yes or no)			
_____ (organization running log)			
(8) how well bottom plugged <u>sand</u> <u>stark</u>			
DRILLERS REMARKS: <u>Good well</u>			


DEPT. OF NATURAL RESOURCES
 BUREAU OF LAND & WATER RESOURCES

APR 23 1981

RECEIVED

If well telescopes please sketch and show depths.

GROUND LEVEL

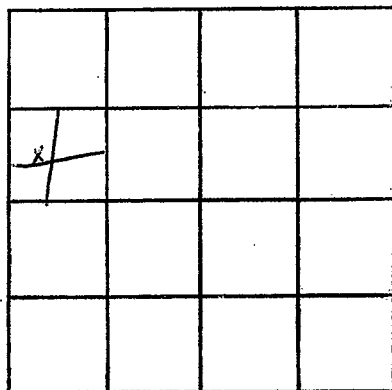

SECTION 17

Please indicate well location X.

ADDITIONAL INFORMATION

If more than one screen,
show locations of each on sketch.