

Marion
 M 2036
 2-18-81

MISSISSIPPI
 BOARD OF WATER COMMISSIONERS
 416 North State Street
 Jackson, Mississippi 39201

WATER WELL DRILLERS LOG

2-18 1981 Hollinger Marion
 date well completed firm name county well located

LANDOWNER: Jimmy Kenney
 East Columbia
 Columbia, MS
 (mailing address)

description of formations encountered	from	to
Sandy gravel	0	100
CLAY	100	140
fine gravel	140	168

WELL LOCATION:
 sec. 16 T. 3 N. R. 17 E.
 6 1/2 miles E of Columbia
 (distance) (direction) (nearest town)

WELL PURPOSE: Home
 (home, irrigation, municipal, industrial)

- WELL COMPLETION DATA:
- (1) diameter (inches) 2
 - (2) total depth (feet) 168
 - (3) static water level (feet) 40 (below above top of ground)
 - (4) casing PVC, 163 (material) (depth)
 - (size) If telescope see back.
 - (5) screen 5, 163 (length) (depth to top)
 - 2, PVC (size) (material)
 - (6) pump 1, 12 (HP) (yield gpm)
 - elect (type power)
 - (7) electric log (yes or no)

(organization running log)

(8) how well bottom plugged sand SHARK

DRILLERS REMARKS: Good well


DEPT. OF NATURAL RESOURCES
 BUREAU OF LAND & WATER RESOURCES

APR 23 1981

RECEIVED

If well telescopes please sketch and show depths.

GROUND LEVEL

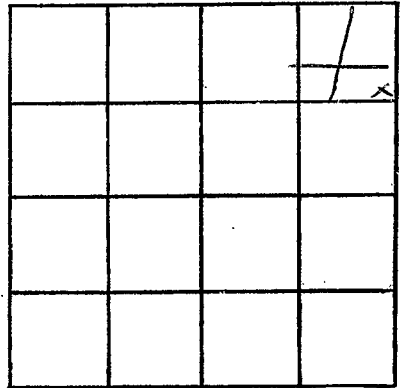

SECTION 16

Please indicate well location X.

ADDITIONAL INFORMATION

Lined area for additional information.

If more than one screen, show locations of each on sketch.