

Marion
M 2038
9-30-80

MISSISSIPPI
BOARD OF WATER COMMISSIONERS
416 North State Street
Jackson, Mississippi 39201

WATER WELL DRILLERS LOG

9/30/80 date well completed
Tom Griffith Well sec. firm name
MARION county well located

LANDOWNER:
Kelly Speights
City -
(mailing address)

description of formations encountered
Top soil SAND & Pea GRAVEL
from 0' to 1' 30"

WELL LOCATION:
sec 36 T 30 N R 14 E ?
5 miles East of City
(distance) (direction) (nearest town)

WELL PURPOSE: Drill
(home, irrigation, municipal, industrial)

- WELL COMPLETION DATA:
- (1) diameter (inches) 4"
 - (2) total depth (feet) 70'
 - (3) static water level (feet) 30' below top of ground.
 - (4) casing plastic, 70'
(material) (depth)
4" If telescope see back.
(size)
 - (5) screen 20', 50'
(length) (depth to top)
4" PVC
(size) (material)
 - (6) pump 1 12 gpm
(HP) (yield/gpm)
Elect.
(type power)
 - (7) electric log No
(yes or no)
 - (organization running log) B.W.U.
 - (8) how well bottom plugged

DRILLERS REMARKS:

DEPT. OF NATURAL RESOURCES
BUREAU OF LAND & WATER RESOURCES

OCT 6 1980

RECEIVED


DEPT. OF NATURAL RESOURCES
BUREAU OF LAND & WATER RESOURCES

OCT - 6 1980

RECEIVED

If well telescopes please sketch and show depths.

GROUND LEVEL

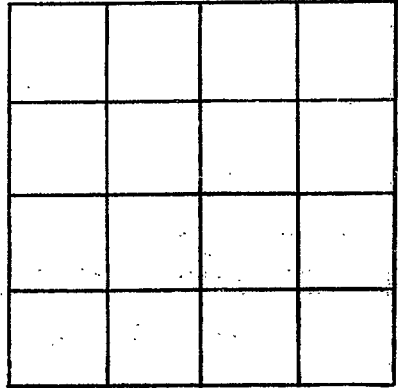

SECTION _____

Please indicate well location X.

ADDITIONAL INFORMATION

If more than one screen, show locations of each on sketch.